



Contract Plans

For Construction of:

009321

SR 525

MUKILTEO FERRY TERMINAL (PHASE 2) FERRY TERMINAL CONSTRUCTION

SNOHOMISH COUNTY

VOLUME 6 OF 8

F. A. NO. TIGER-WA-2017-007, CFDA 20933
F. A. NO. PSRC-WA-2017-023, CFDA 20507



**Washington State
Department of Transportation**

VOLUME 6 SHEET INDEX

SHT NO. PLAN NO. DESCRIPTION

INDEX

15 10.14 COVER SHEET
VOLUME 6 SHEET INDEX

ARCHITECTURAL

1377 AX00.01 CODE INFORMATION, GENERAL NOTES, INDEX, LEGENDS, AND ABBREVIATIONS
1378 AX01.01 FLOOR PLAN, ELEVATIONS
1379 AX03.01 BUILDING SECTIONS WINDOW AND DOOR SCHEDULES
1380 AX05.01 EXTERIOR DETAILS
1381 AX05.02 EXTERIOR DETAILS
1382 AX05.03 DOOR DETAILS
1383 AX05.04 WINDOW DETAILS
1384 AX06.01 CASEWORK #1 DRAWINGS
1385 AX06.02 CASEWORK #1 SECTIONS
1386 AX06.03 CASEWORK #2 DRAWINGS
1387 AX06.04 DETAILS

1388 SX00.10 ABBREVIATIONS AND SYMBOLS
1389 SX00.11 GENERAL STRUCTURAL NOTES
1390 SX01.10 FOUNDATION AND FLOOR PLAN
1391 SX01.11 TOLL BOOTH PLANS
1392 SX01.12 TOLL BOOTH ELEVATIONS I
1393 SX01.13 TOLL BOOTH ELEVATIONS II
1394 SX01.14 TOLL BOOTH SECTIONS AND DETAILS
1395 SX01.15 TYPICAL DETAILS


ELECTRICAL

1396 EX01.00 ELECTRICAL SYMBOLS
1397 EX01.01 ELECTRICAL ABBREVIATIONS AND NOTES
1398 EX02.00 TOLLBOOTH ELECTRICAL PLAN
1399 EX02.01 TOLLBOOTH COMMUNICATIONS PLAN
1400 EX02.02 TOLLBOOTH ATTIC ELECTRICAL PLAN
1401 EX02.03 TOOLBOOTH ELEVATIONS
1402 EX03.00 LOOP DETECTOR INSTALLATION
1403 EX04.00 TOOL BOOTH PANELBOARD SCHEDULES
1404 EX04.01 TOOL BOOTH PANELBOARD SCHEDULES

MECHANICAL

1405 MX01.20 MECHANICAL PLANS AND SECTIONS




FILE NAME: PW:\WSF\Mukilteo\14W121_FerryTermConst\CADD\KPFF\18w121io00_14.dlv									SR 525 MUKILTEO FERRY TERMINAL (PHASE 2) FERRY TERMINAL CONSTRUCTION	10.14		
PRINTED: 11:26:11 AM 9/13/2018	LAST PRINTED BY:				FED.AID PROJ.NO.							
SUBMITTAL DATE: 9/21/18	R. JACKSON				WA-2017-007-00				VOLUME 6 SHEET INDEX	SHEET 15 OF 1521 SHEETS		
DESIGNED BY: A. GASTINEAU	9/21/18				REGION NO. STATE							
ENTERED BY: R. JACKSON	9/21/18				10 WASH							
CHECKED BY: D. ALIRE	9/21/18				JOB NUMBER 18W121							
MAR PROJ ENGR: C. TORRES					CONTRACT NO. 00****							
DIR TERM ENGR: N. MCINTOSH												
ASST SECRETARY: A. SCARTON		REVISION	DATE	BY								


ABBREVIATIONS

A/C	AIR CONDITIONER	MAX	MAXIMUM
AFF	ABOVE FINISH FLOOR	MECH	MECHANICAL
ALUM	ALUMINUM	MIN	MINIMUM
AP	ACCESS PANEL	MTL	METAL
ADJ.	ADJACENT OR ADJUST	NIC	NOT IN CONTRACT
℄	CENTERLINE	NTS	NOT TO SCALE
BLDG	BUILDING	O/	OVER
BLKG	BLOCKING	OC	ON CENTER
CLG	CEILING	OPNG	OPENING
CONT	CONTINUOUS	OH	OPPOSITE HAND
CTR	CENTER	PT	PRESSURE TREAT
DIM	DIMENSION	P-LAM	PLASTIC LAMINATE
DS	DOWNSPOUT	PLYWD	PLYWOOD
EA	EACH	REF	REFERENCE
ELEC	ELECTRICAL	REQ'D	REQUIRED
EQUIP	EQUIPMENT	RO	ROUGH OPENING
EXIST, (E)	EXISTING	SIM	SIMILAR
FF	FINISH FLOOR	SS	STAINLESS STEEL
FOIC	FURNISHED BY OWNER, INSTALLED BY CONTRACTOR	STND	STANDARD
FTP	FARE TRANSACTION PROCESSOR	STL	STEEL
GALV	GALVANIZED	STRUCT	STRUCTURAL
GL	GLASS	T.O.	TOP OF
GWB	GYPSUM WALLBOARD	TYP	TYPICAL
HDR	HEADER	W/	WITH
HM	HOLLOW METAL	WD	WOOD
INSUL	INSULATION OR INSULATED	W/O	WITHOUT
MATL	MATERIAL	UNO	UNLESS NOTED OTHERWISE
		UPS	UNINTERRUPTED POWER SOURCE

SYMBOLS LEGEND

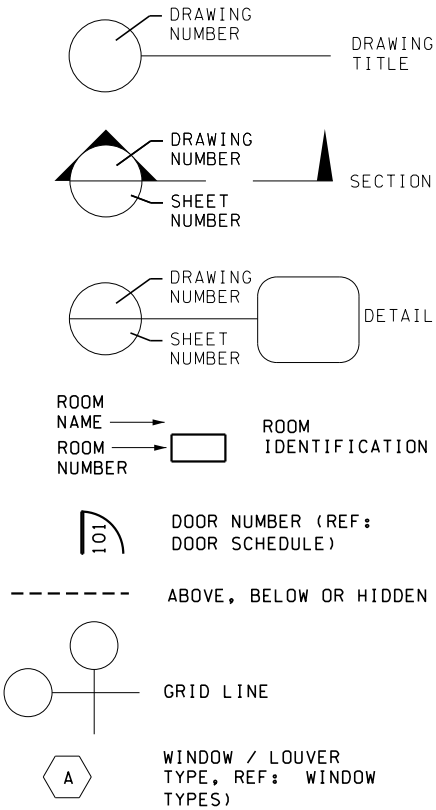

MATERIALS LEGEND

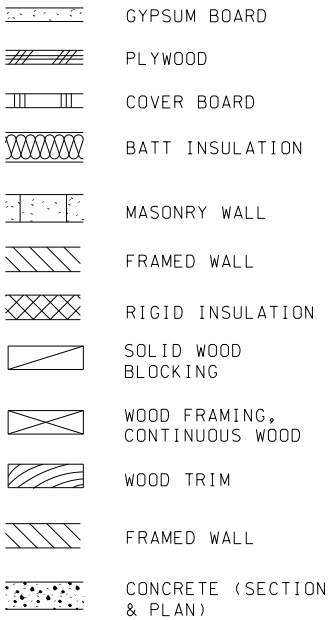

GENERAL NOTES

- ALL WORK SHALL CONFORM TO APPLICABLE BUILDING CODES AND ORDINANCES. WHERE MORE THAN ONE CODE OR ORDINANCE CONFLICT WITH EACH OTHER, THE MORE RESTRICTIVE CODE SHALL GOVERN.
- THE CONTRACTOR SHALL VERIFY ALL EXISTING CONDITIONS AT THE SITE AND SHALL NOTIFY ARCHITECT/ENGINEER IMMEDIATELY OF ANY UNCERTAINTIES OR DISCREPANCIES WITH THE DRAWINGS.
- THE CONTRACTOR SHALL VERIFY THE LOCATIONS OF ALL UTILITIES AT THE SITE, PROTECT THEM FROM DAMAGE AND REPORT ANY DISCREPANCIES WITH THE DRAWINGS.
- THE CONTRACTOR SHALL INSURE THE HEALTH AND SAFETY OF THE PUBLIC AND ALL WHO ENTER THE BUILDING DURING CONSTRUCTION.
- THE CONTRACTOR SHALL VERIFY AND COORDINATE THE WORK OF SUBCONTRACTORS AND ALL DRAWINGS PRIOR TO PROCEEDING WITH ANY WORK OR FABRICATION.
- DRAWINGS SHALL NOT BE SCALED. NOTIFY THE ARCHITECT/ENGINEER IMMEDIATELY OF ANY CONFLICTS.
- THE CONTRACTOR SHALL BE RESPONSIBLE FOR CONSTRUCTION OF MECHANICAL AND ELECTRICAL WORK AS REQUIRED TO COMPLETE CONSTRUCTION AND SHALL PROVIDE ALL NECESSARY SHAFTS, OPENINGS, BASES AND STRUCTURAL SUPPORT FOR DUCTS, CONDUITS AND EQUIPMENT.
- DIMENSIONS ON PLANS ARE FACE OF STUD, CENTER OF COLUMN, CENTER OF MULLION OR FACE OF CONCRETE UNLESS OTHERWISE NOTED.
- LABORATORY TESTING AND INSPECTION REQUIRED FOR ALL EARTHWORK COMPACTION, SITE WELDING, HIGH STRENGTH BOLTING AND ALL STRUCTURAL CONCRETE. CONTRACTOR TO PROVIDE INDEPENDENT TESTING LAB OR COORDINATE A WSDOT INSPECTOR, FOR ALL CODE REQUIRED TESTING.
- CAULK ALL WINDOW, DOOR, CORNER, AND OTHER WOOD TRIM JOINTS AFTER PRIMING, BUT PRIOR TO APPLICATION OF THE TOP COATS.

PROJECT INFORMATION

OWNER: WASHINGTON STATE DEPARTMENT OF TRANSPORTATION

ADDRESS: MUKILTEO FERRY TERMINAL
MUKILTEO, WA

LEGAL DESCRIPTION: SEE SUNDRY SITE PLAN

PARCEL NO: EXEMPT

CODE INFORMATION

PERMITTING AGENCY:

GOVERNING CODE:
2015 WASHINGTON STATE BUILDING CODE. INCLUDES ADOPTION OF AND AMENDMENTS TO:
2015 INTERNATIONAL BUILDING CODE,
ICC/ANSI A117.1-09,
2015 INTERNATIONAL MECHANICAL CODE,
2015 INTERNATIONAL FIRE CODE,
2015 UNIFORM PLUMBING CODE,
2015 NATIONAL ELECTRICAL CODE (NFPA 70)

OCCUPANCY GROUPS / FLOOR AREA:
GROUP B - BUSINESS / 69 SF EACH (TYP OF 3)

CONSTRUCTION TYPE:
TYPE V-B

BUILDING SHEET INDEX

SHT. NO.	PLAN NO.	DESCRIPTION
ARCHITECTURAL		
	AX00.01	CODE INFORMATION, GENERAL NOTES, INDEX, LEGENDS & ABBREVIATIONS
	AX01.01	FLOOR PLAN, ELEVATIONS
	AX03.01	BUILDING SECTIONS, WINDOW AND DOOR SCHEDULES
	AX05.01	EXTERIOR DETAILS
	AX05.02	EXTERIOR DETAILS
	AX05.03	DOOR DETAILS
	AX05.04	WINDOW DETAILS
	AX06.01	CASEWORK #1 DRAWINGS
	AX06.02	CASEWORK #1 SECTIONS
	AX06.03	CASEWORK #2 DRAWINGS
	AX06.04	DETAILS
STRUCTURAL		
	SX00.10	ABBREVIATIONS AND SYMBOLS
	SX00.11	GENERAL STRUCTURAL NOTES
	SX00.12	GENERAL STRUCTURAL NOTES
	SX01.10	PLANS
	SX01.11	PLANS
	SX01.12	ELEVATIONS
	SX01.13	ELEVATIONS
	SX01.14	SECTIONS AND DETAILS
	SX01.15	TYPICAL DETAILS
ELECTRICAL		
	EX01.00	ELECTRICAL SYMBOLS
	EX01.01	ELECTRICAL ABBREVIATIONS AND NOTES
	EX02.00	TOLLBOOTH ELECTRICAL PLAN
	EX02.01	TOLLBOOTH COMMUNICATIONS PLAN
	EX02.02	TOLLBOOTH ATTIC ELECTRICAL PLAN
	EX02.03	TOLLBOOTH ELEVATIONS
	EX03.00	LOOP DETECTOR INSTALLATION
	EX04.00	TOLLBOOTH PANELBOARD SCHEDULES
	EX04.01	TOLLBOOTH PANELBOARD SCHEDULES
MECHANICAL		
	MX01.20	MECHANICAL PLAN AND SECTION

FILE NAME: WSF\Mukilteo\14W121_FerryTermConst\CADD\WSF\ \$FILES\$					
PRINTED: 2:03:07 PM 9/21/2018	LAST PRINTED BY: Morin				FED.AID PROJ.NO.
SUBMITTAL DATE: 9/21/2018					WA-2017-007-00
DESIGNED BY: S. LEACH	9/21/2018				REGION NO. STATE
ENTERED BY: M. MORIN	9/21/2018				10 WASH
CHECKED BY: M. SCOTT	9/21/2018				JOB NUMBER
MAR PROJ ENGR: C. TORRES	9/21/2018				18W121
DIR TERM ENGR: N. MCINTOSH		ADDENDUM NO. 2	11/01/18		CONTRACT NO.
ASST SECRETARY: A. SCARTON		REVISION	DATE	BY	00*****




SR 525
MUKILTEO FERRY TERMINAL (PHASE 2)
FERRY TERMINAL CONSTRUCTION


CODE INFORMATION, GENERAL NOTES,
INDEX, LEGENDS, AND ABBREVIATIONS

AX00.01


SHEET
1377
OF
1521
SHEETS

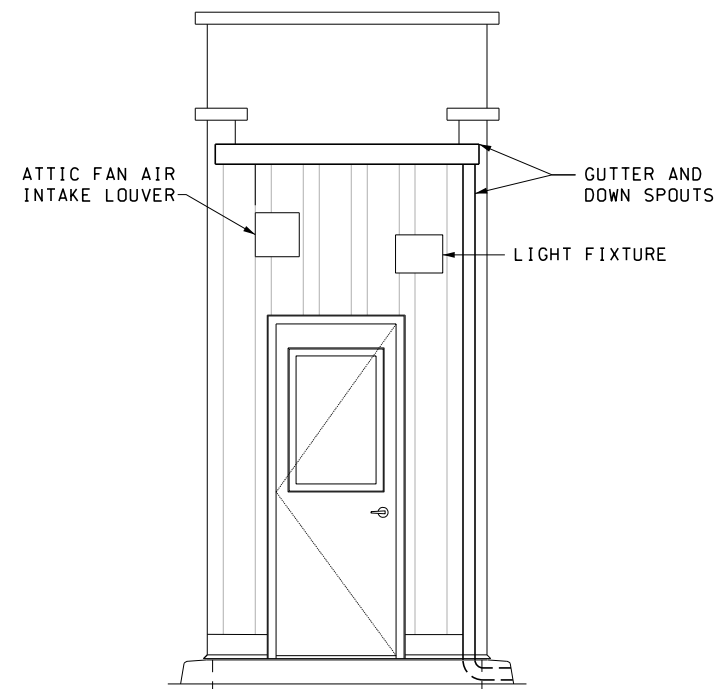


A REAR ELEVATION

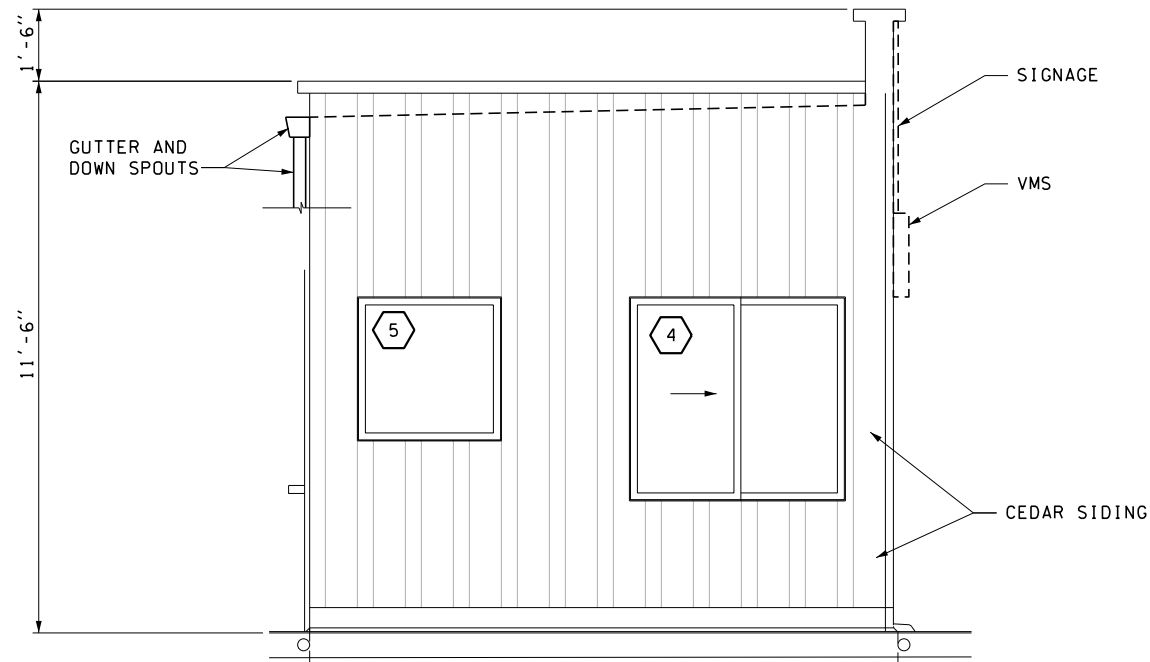


B SIDE ELEVATION

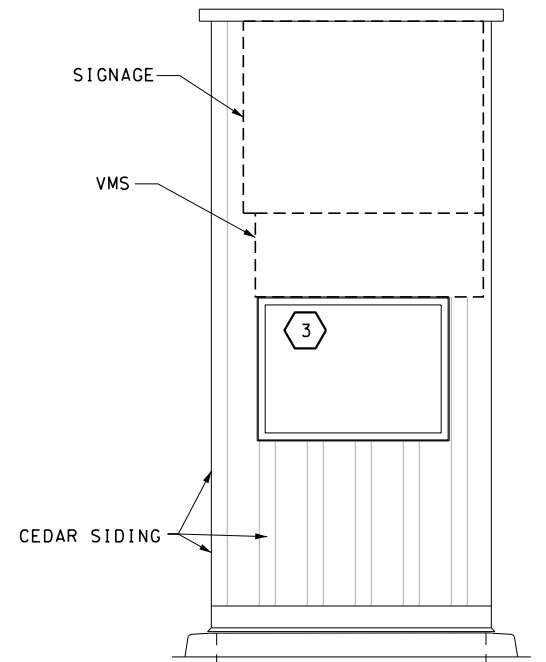

C FRONT ELEVATION

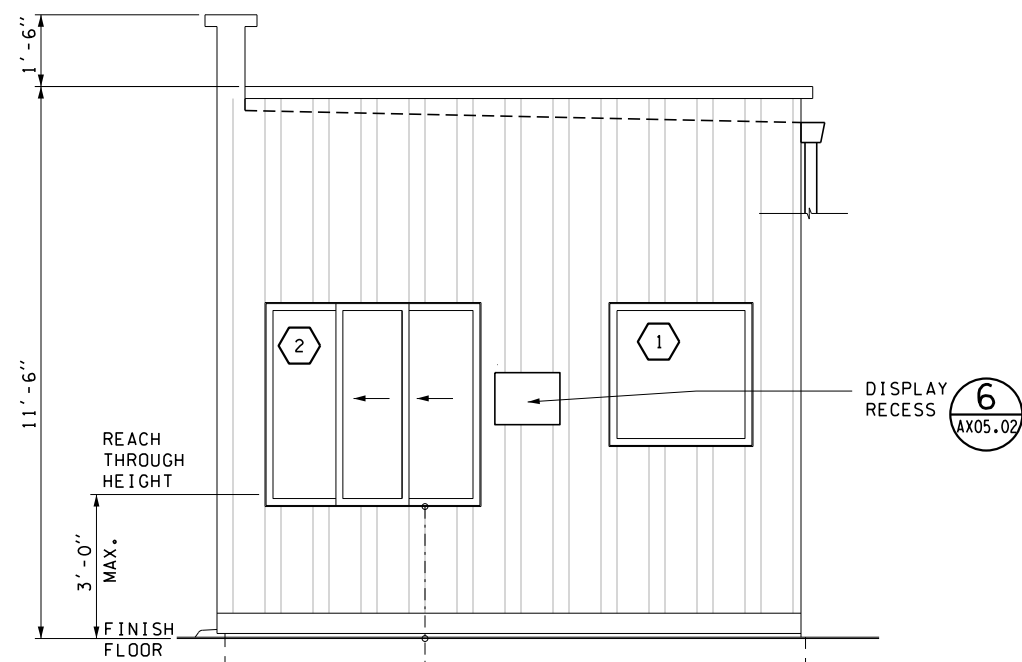

D SERVICE SIDE ELEVATION

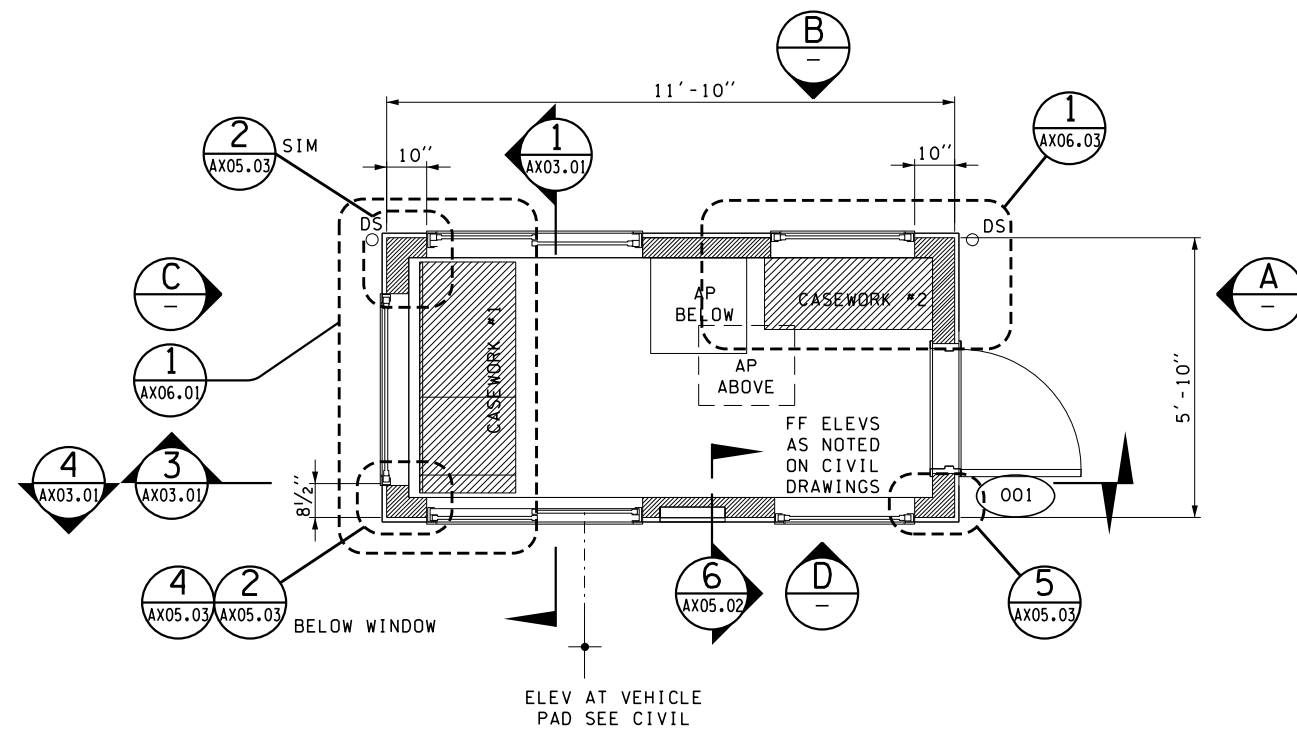

FLOOR PLAN


0 1 2 1/4

FILE NAME: WSF\Mukilteo\14W121_FerryTermConst\CADD\WSF\ \$FILES\$					
PRINTED: 2:03:17 PM 9/21/2018		LAST PRINTED BY: Morin		FED.AID PROJ.NO.	
SUBMITTAL DATE: 9/21/2018		DESIGNED BY: S. LEACH		WA-2017-007-00	
ENTERED BY: M. MORIN		9/21/2018		REGION NO. STATE	
CHECKED BY: M. SCOTT		9/21/2018		10 WASH	
MAR PROJ ENGR: C. TORRES		9/21/2018		JOB NUMBER	
DIR TERM ENGR: N. MCINTOSH		18W121		CONTRACT NO.	
ASST SECRETARY: A. SCARTON		00****			
ADDENDUM NO. 2		11/01/18			
REVISION		DATE		BY	




SR 525
MUKILTEO FERRY TERMINAL (PHASE 2)
FERRY TERMINAL CONSTRUCTION
FLOOR PLAN, ELEVATIONS

AX01.01
SHEET
1378
OF
1521
SHEETS

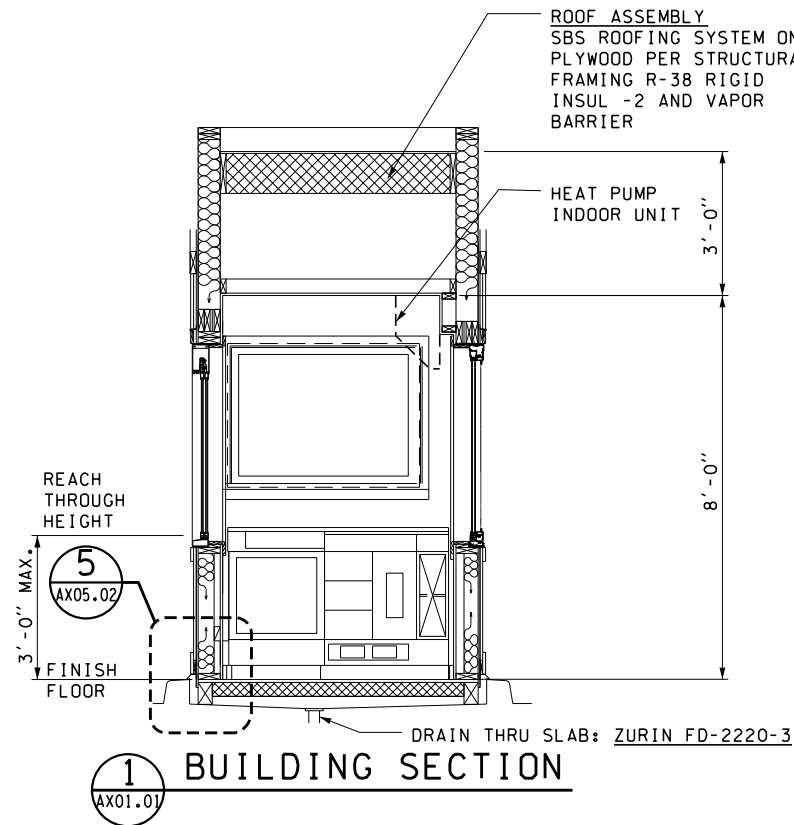

CEILING ASSEMBLY:
PLYWOOD PER STRUCT @ ATTIC SIDE
FRAMING (SEE STRUCTURAL) WITH
5*8" GWB @ OCCUPIED SIDE

WALL ASSEMBLY:
CEDAR SIDING ON
BUILDING PAPER ON WALL
SHEATHING. PER STRUCT. ON
FRAMING (SEE STRUCTURAL) W/
R-21 BATT INSUL. AND VAPOR BARRIER
W/ 5/8" GWB INTERIOR FINISH.

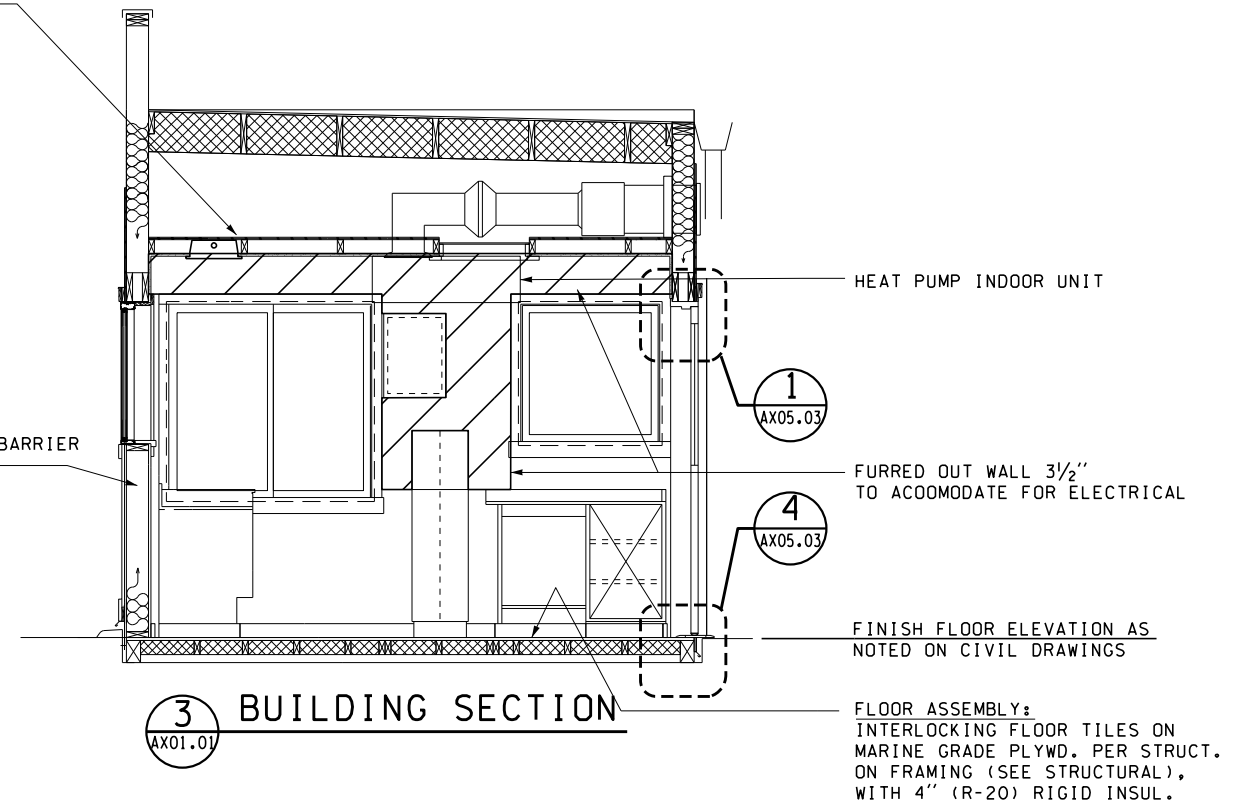

WINDOW SCHEDULE


MARK	SIZE (NOMINAL)	FUNCTION	FRAME	HEAD	SILL	JAMB	REMARKS
1	3'-0" x 3'-0"	FIXED	ALUM	4/AX05.04	4/AX05.04	4/AX05.03	PROVIDE BLINDS
2	4'-6" x 4'-3"	SLIDER	ALUM	1/AX05.04 SIM	4/AX05.04 5/AX05.04	5/AX05.03	SELLER'S WINDOW
3	4'-0" x 3'-0"	FIXED	ALUM	1/AX05.04	4/AX05.04	1/AX05.03 4/AX05.03	PROVIDE BLINDS
4	4'-6" x 4'-3"	SLIDER	ALUM		6/AX05.04	1/AX05.03	
5	3'-0" x 3'-0"	FIXED	ALUM	1/AX05.04	4/AX05.04	5/AX05.03 SIM	

DOOR SCHEDULE

MARK	SIZE	FUNCTION	FRAME	HEAD	SILL	JAMB	REMARKS
001	2'-6" x 7'-0"	SWING	HM	3/AX05.03	6/AX05.03	5/AX05.03	INSUL. HM; 5/8" GLASS (SAFETY GLAZING); 24"x36" REFER TO ARCH. SPEC'S FOR H.M. DOORS AND HARDWARE HARDWARE GROUP #18


NOTE:
SEE ABOVE FOR TYPICAL NOTES.

ATTIC
ACCESS PANEL
6
AX06.04

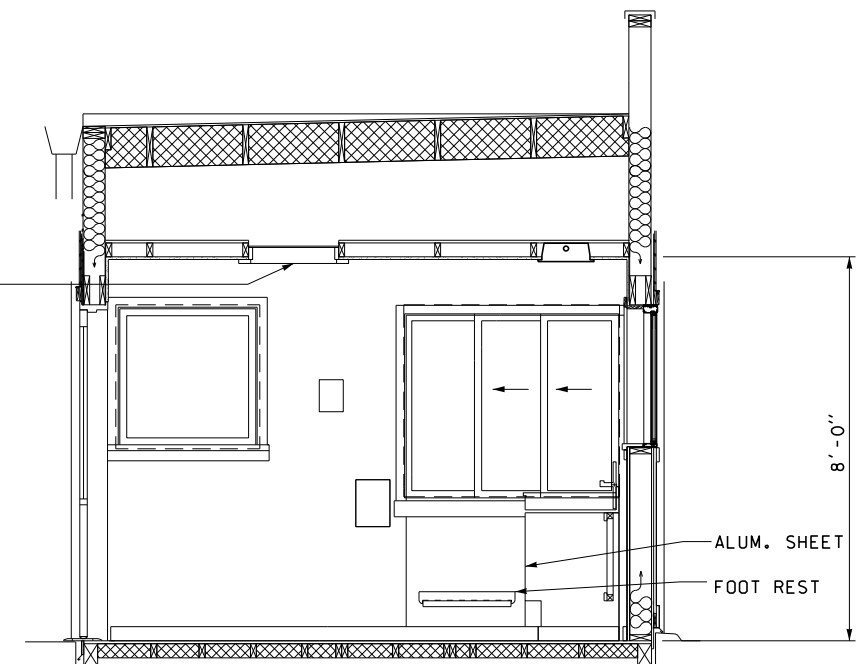







0 1 2 1/4

FILE NAME: WSF\Mukilteo\14W121_FerryTermConst\CADD\WSF\ \$FILES\$							
PRINTED: 2:03:26 PM 9/21/2018		LAST PRINTED BY:		FED.AID PROJ.NO.			
SUBMITTAL DATE: 9/21/2018		Morin		WA-2017-007-00			
DESIGNED BY: S. LEACH		9/21/2018		REGION NO. STATE		10 WASH	
ENTERED BY: M. MORIN		9/21/2018		JOB NUMBER		18W121	
CHECKED BY: M. SCOTT		9/21/2018		CONTRACT NO.		00*****	
MAR PROJ ENGR: C. TORRES		9/21/2018		ADDENDUM NO. 2		11/01/18	
DIR TERM ENGR: N. MCINTOSH				REVISION		DATE	
ASST SECRETARY: A. SCARTON						BY	

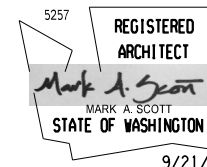

SR 525
MUKILTEO FERRY TERMINAL (PHASE 2)
FERRY TERMINAL CONSTRUCTION
BUILDING SECTIONS WINDOW
AND DOOR SCHEDULES

AX03.01
SHEET
1379
OF
1521
SHEETS

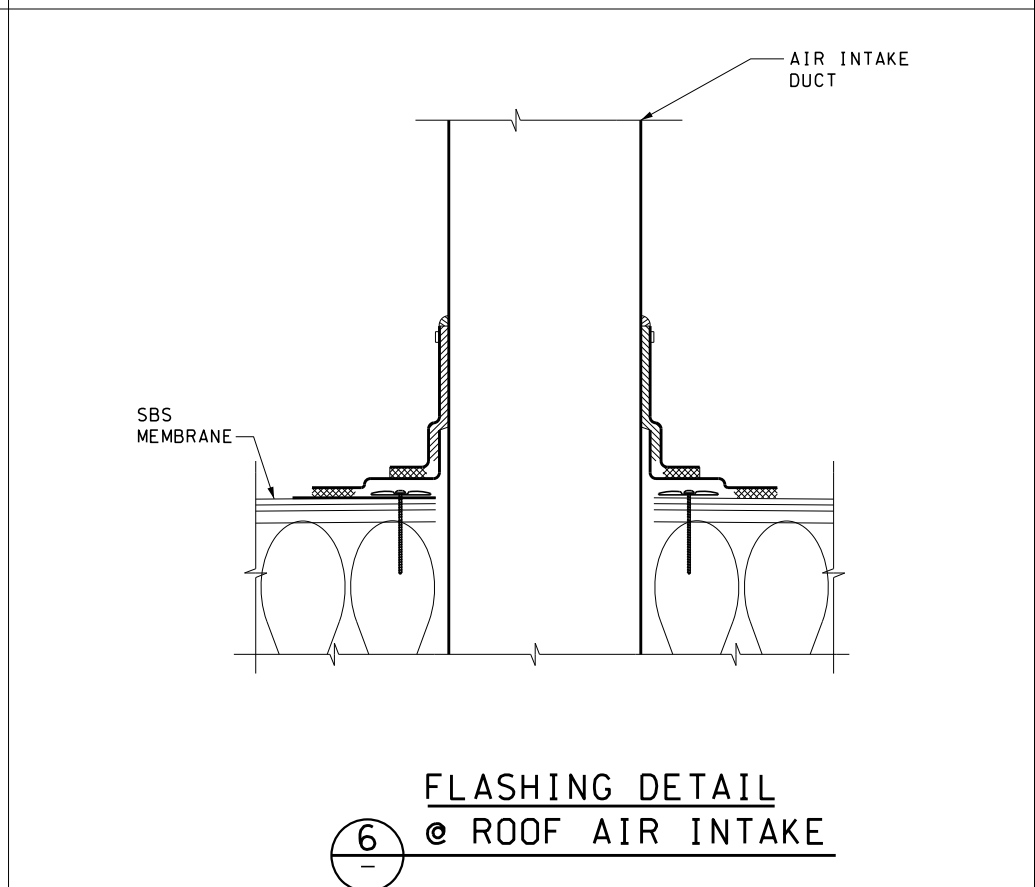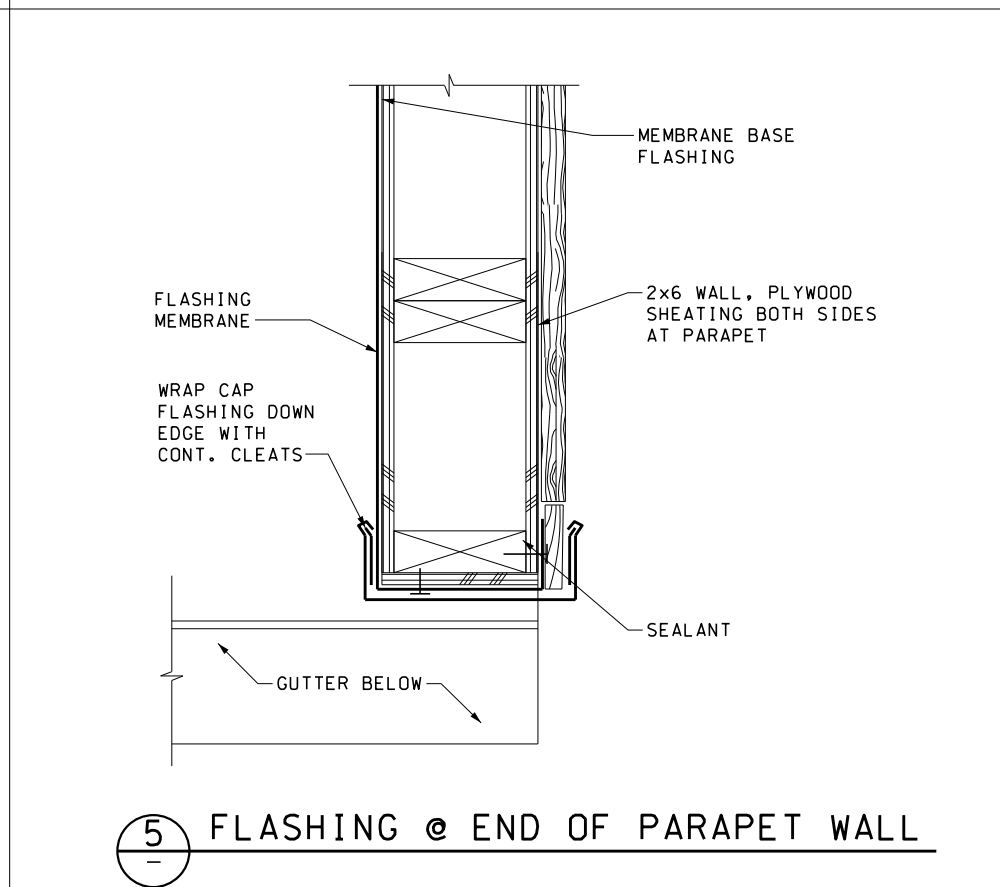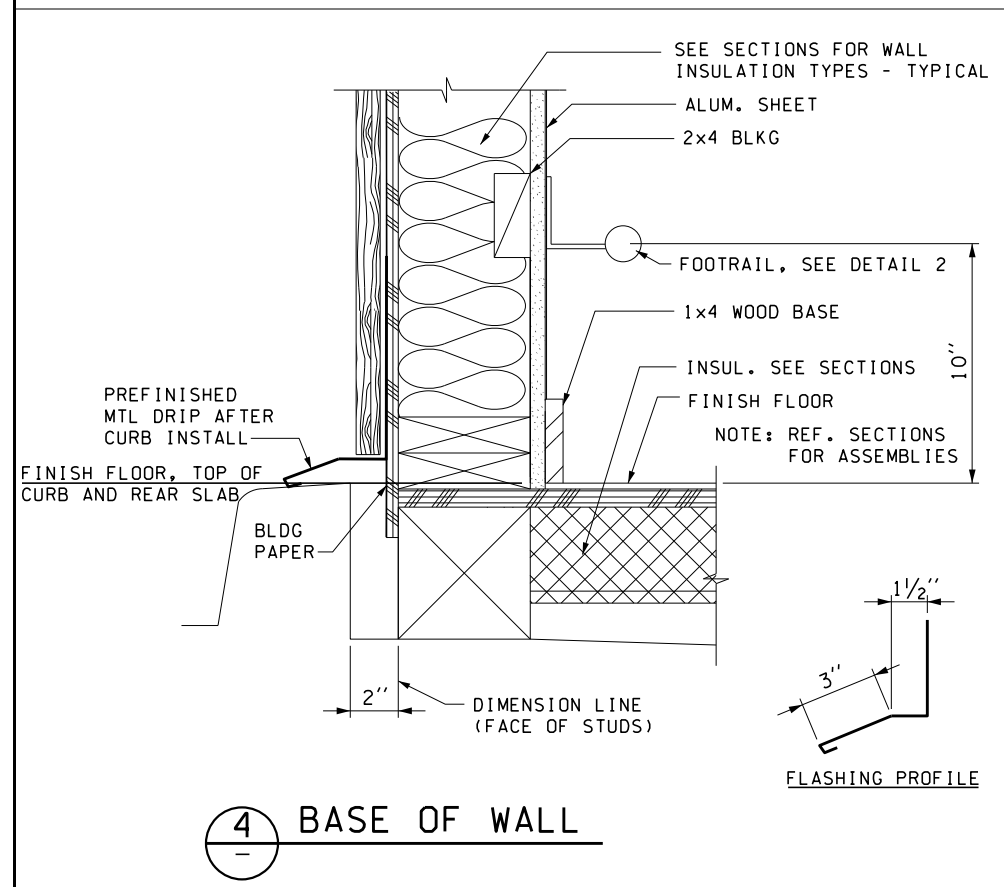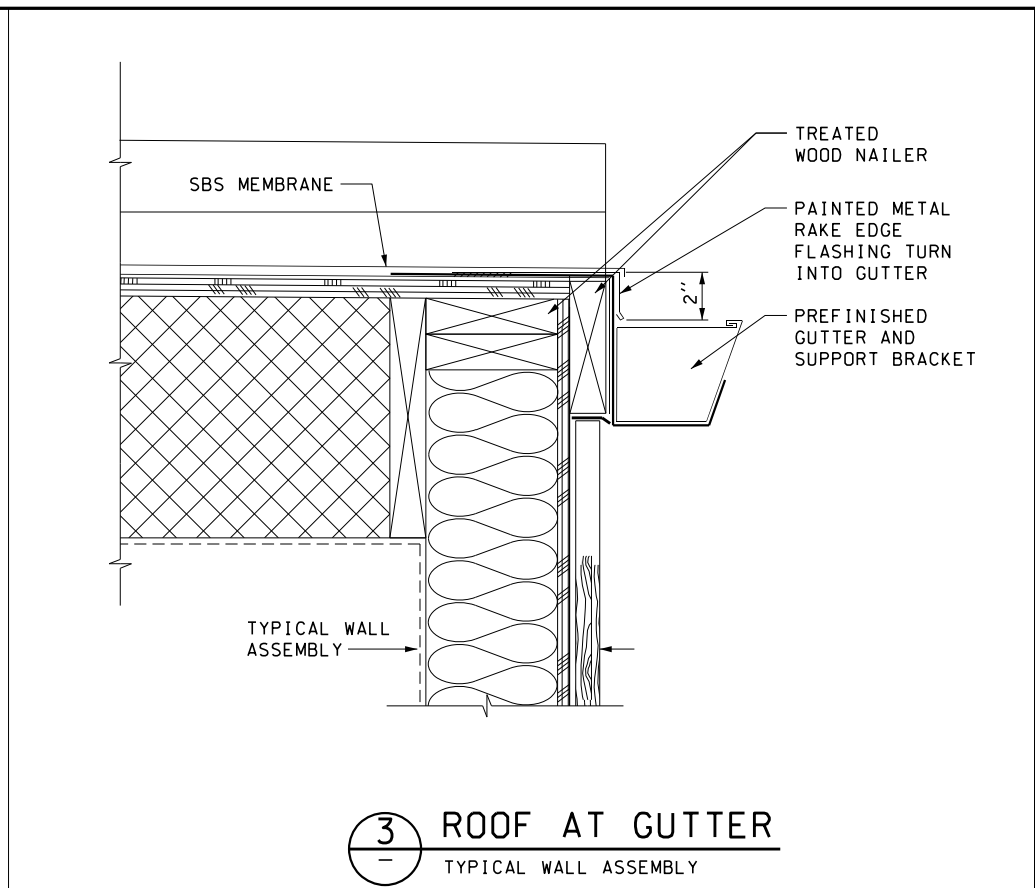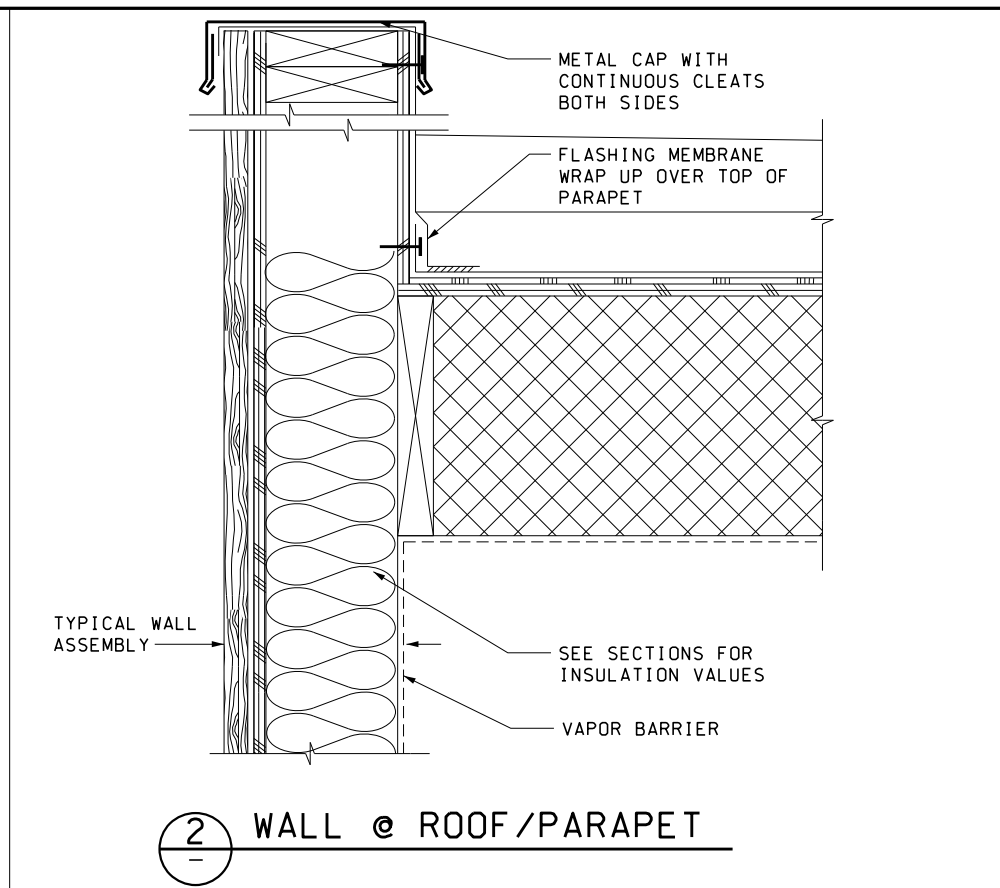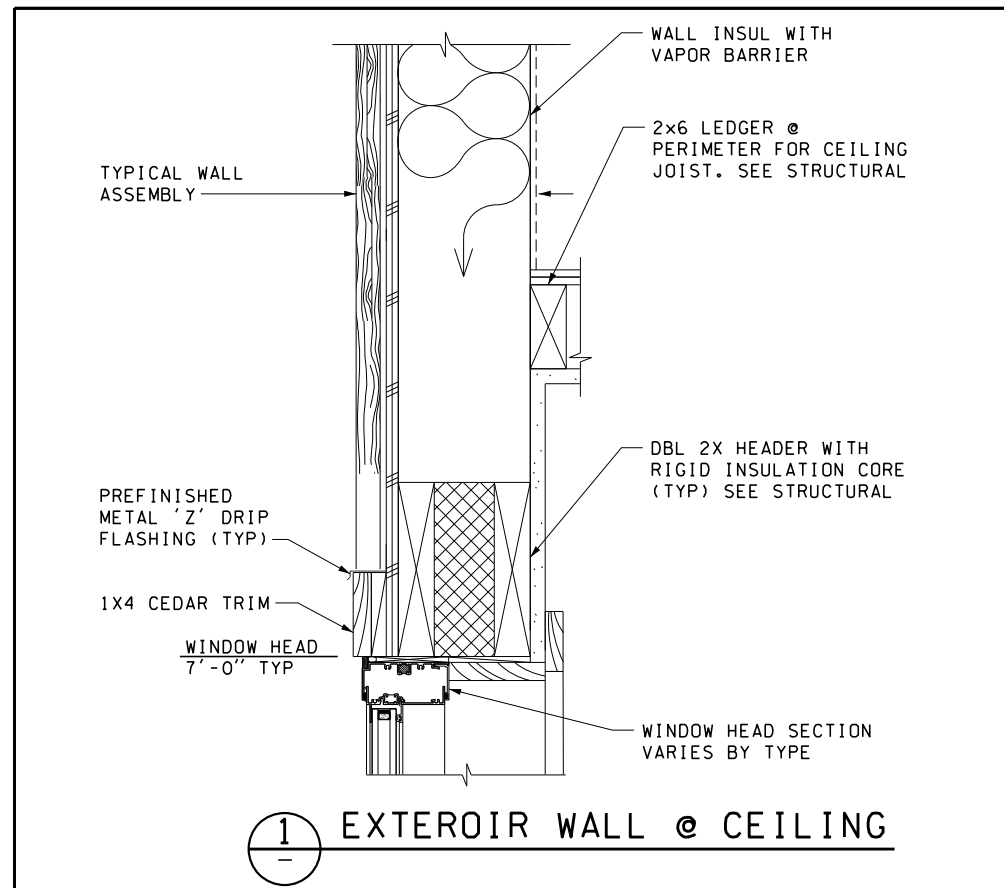

FILE NAME: WSF\Mukilteo\14W121_FerryTermConst\CADD\WSF\ \$FILES\$				PRINTED: 2:03:30 PM 9/21/2018				LAST PRINTED BY: Morin				FED.AID PROJ.NO.			
SUBMITTAL DATE: 9/21/2018				DESIGNED BY: S. LEACH				9/21/2018				WA-2017-007-00			
ENTERED BY: M. MORIN				CHECKED BY: M. SCOTT				9/21/2018				REGION NO. STATE			
MAR PROJ ENGR: C. TORRES				DIR TERM ENGR: N. MCINTOSH				9/21/2018				10 WASH			
ASST SECRETARY: A. SCARTON				ADDENDUM NO. 2				11/01/18				JOB NUMBER			
				REVISION				DATE				BY			
												CONTRACT NO.			
												00****			

5257

REGISTERED ARCHITECT

Mark A. Scott

MARK A. SCOTT

STATE OF WASHINGTON

9/21/2018

Washington State
Department of Transportation
WASHINGTON STATE FERRIES

SR 525




MUKILTEO FERRY TERMINAL (PHASE 2)

FERRY TERMINAL CONSTRUCTION

EXTERIOR DETAILS


AX05.01

SHEET 1380 OF 1521 SHEETS

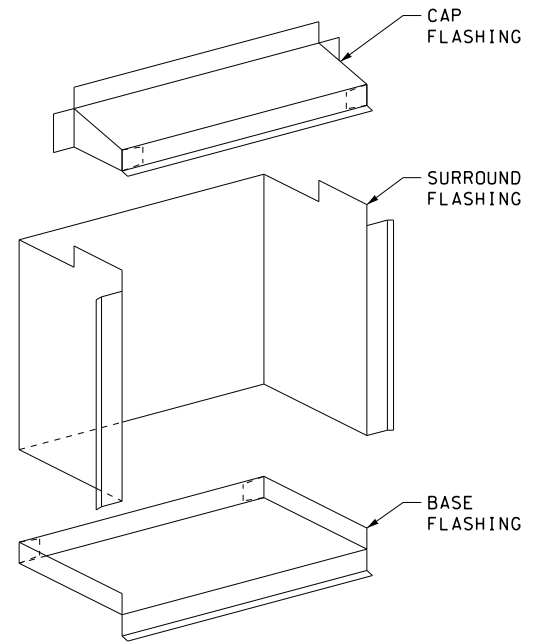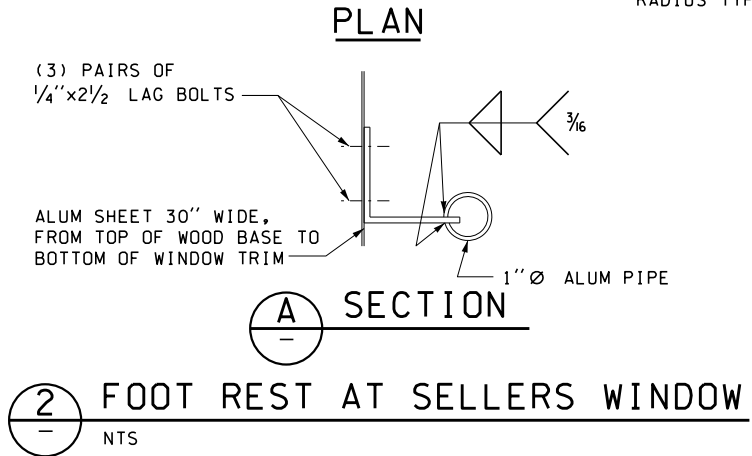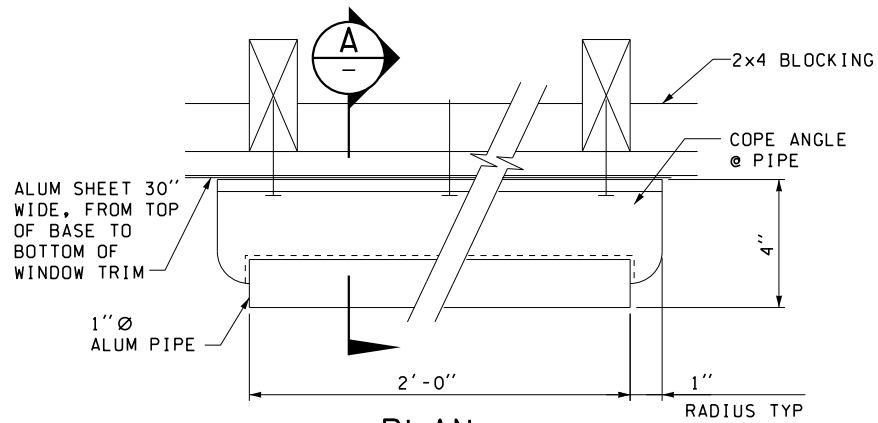


NOTE:
ALL FLASHING
PRE-FINISHED METAL.

3 FLASHING DETAIL
NTS

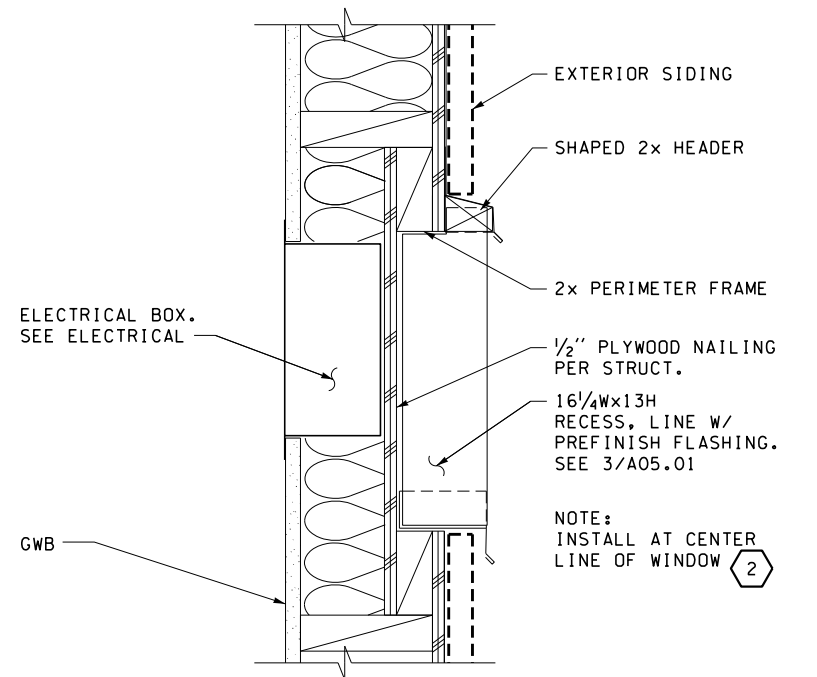


FILE NAME: WSF\Mukilteo\14W121_FerryTermConst\CADD\WSF\ \$FILES\$									
PRINTED: 2:03:37 PM 9/21/2018	LAST PRINTED BY: Morin					FED.AID PROJ.NO.			
SUBMITTAL DATE: 9/21/2018						WA-2017-007-00			
DESIGNED BY: S. LEACH	9/21/2018					REGION NO. STATE			
ENTERED BY: M. MORIN	9/21/2018					10 WASH			
CHECKED BY: M. SCOTT	9/21/2018					JOB NUMBER			
MAR PROJ ENGR: C. TORRES	9/21/2018					18W121			
DIR TERM ENGR: N. MCINTOSH		ADDENDUM NO. 2	11/01/18			CONTRACT NO.			
ASST SECRETARY: A. SCARTON		REVISION	DATE	BY		00****			

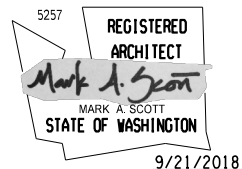


SR 525
MUKILTEO FERRY TERMINAL (PHASE 2)
FERRY TERMINAL CONSTRUCTION
EXTERIOR DETAILS


AX05.02
SHEET
1381
OF
1521
SHEETS

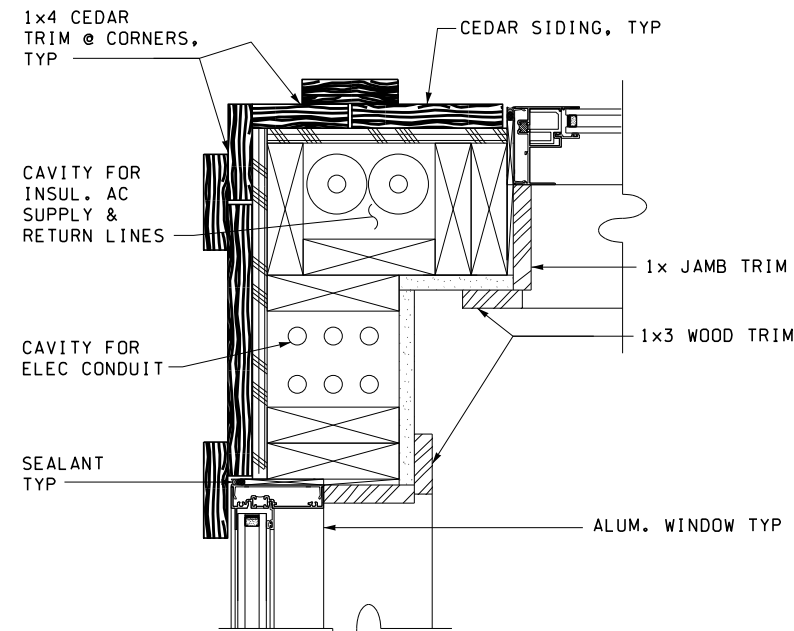


① PLAN VIEW AT CORNER

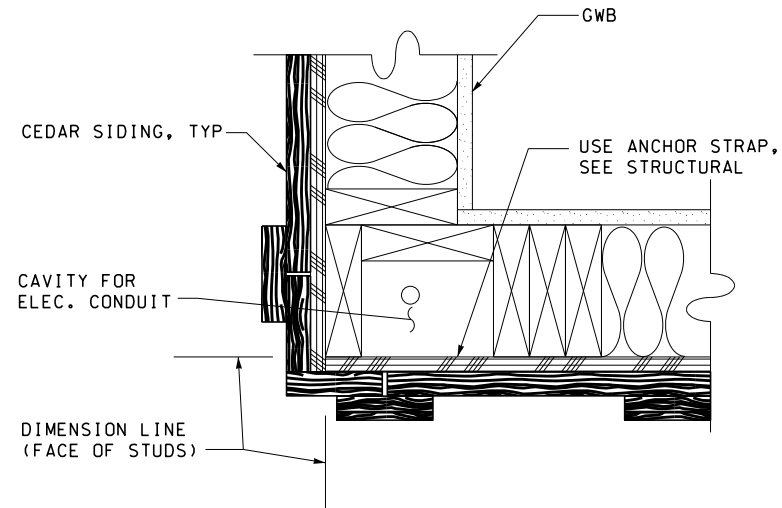


② PLAN AT CORNER (BELOW WINDOW)

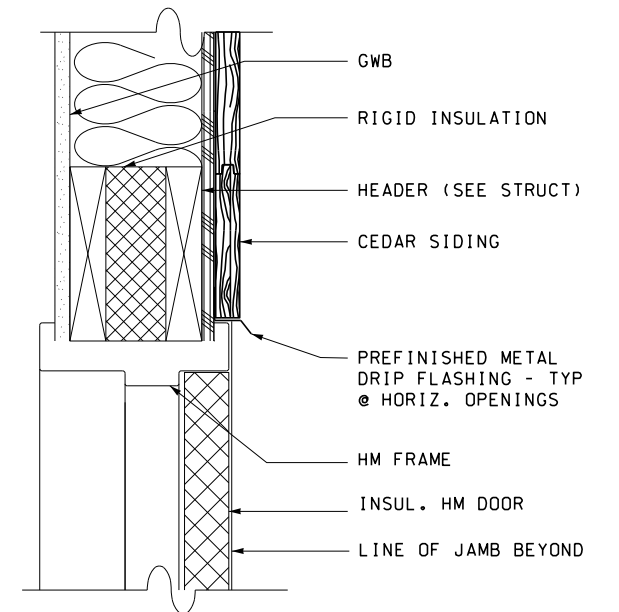


③ DOOR HEAD

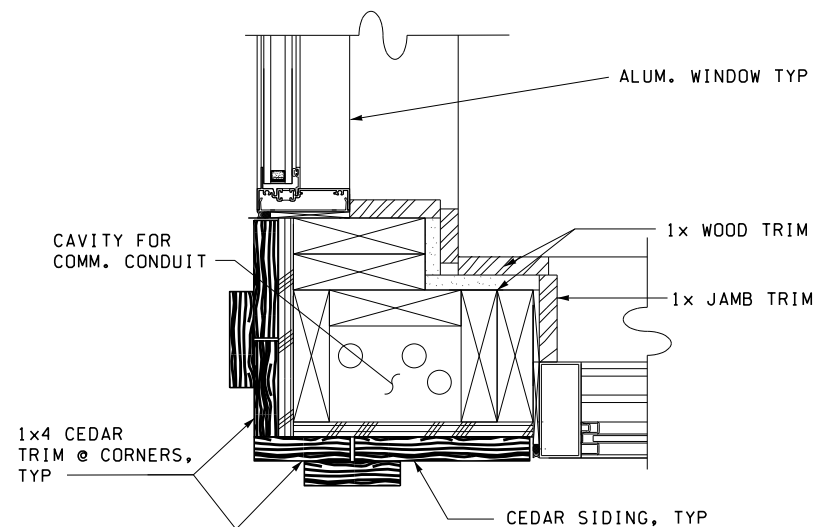

④ PLAN VIEW AT CORNER

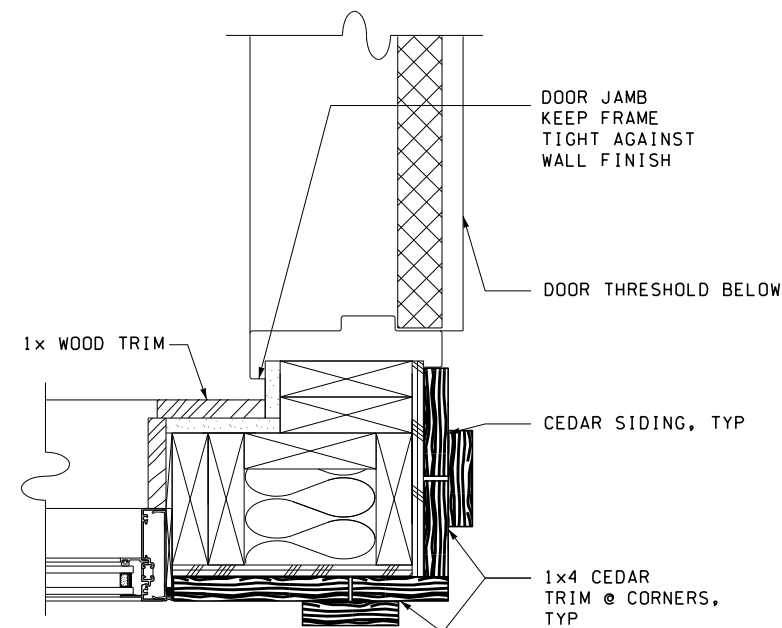

⑤ PLAN AT CORNER (WINDOW/DOOR JAMB)

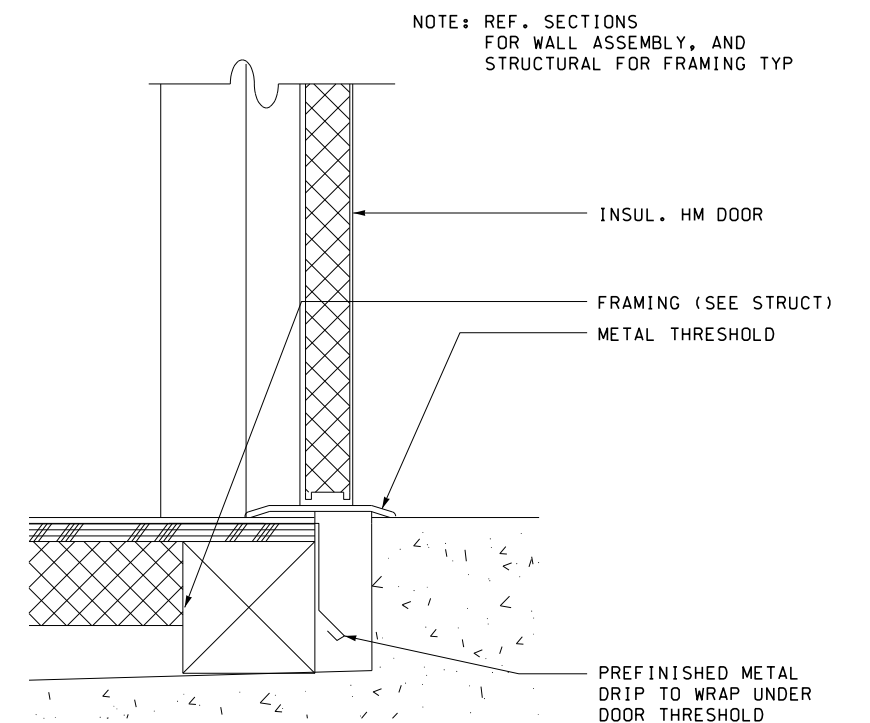

⑥ DOOR THRESHOLD


0 3 6 1 1/2

FILE NAME: WSF\Mukilteo\14W121_FerryTermConst\CADD\WSF\ \$FILES\$									
PRINTED: 2:03:44 PM 9/21/2018		LAST PRINTED BY: Morin		FED.AID PROJ.NO.					
SUBMITTAL DATE: 9/21/2018		DESIGNED BY: S. LEACH		9/21/2018		WA-2017-007-00			
ENTERED BY: M. MORIN		9/21/2018		REGION NO. STATE		10 WASH			
CHECKED BY: M. SCOTT		9/21/2018		JOB NUMBER		18W121			
MAR PROJ ENGR: C. TORRES		9/21/2018		CONTRACT NO.		00****			
DIR TERM ENGR: N. MCINTOSH		ADDENDUM NO. 2		11/01/18					
ASST SECRETARY: A. SCARTON		REVISION		DATE		BY			




SR 525
MUKILTEO FERRY TERMINAL (PHASE 2)
FERRY TERMINAL CONSTRUCTION
DOOR DETAILS


AX05.03
SHEET 1382 OF 1521 SHEETS

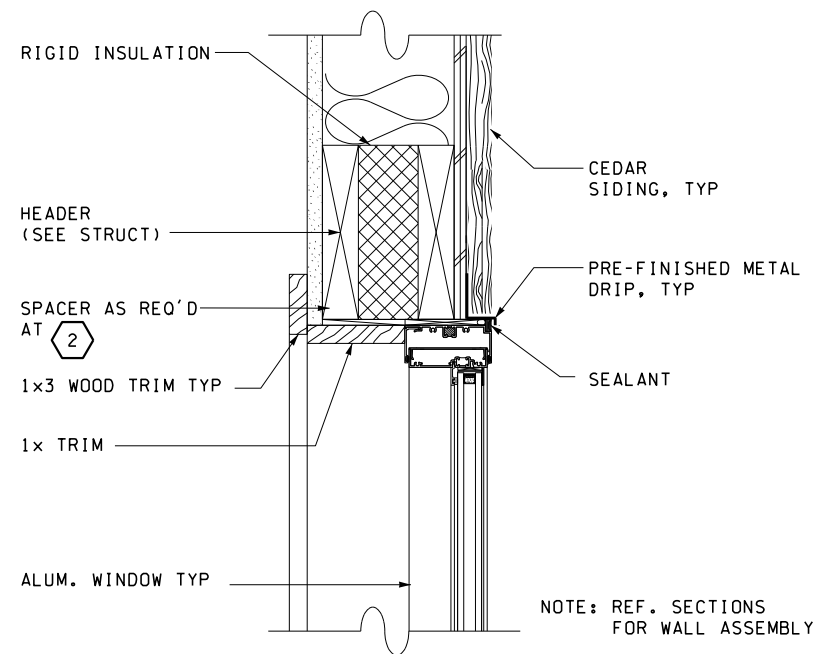


1 FIXED WINDOW HEAD

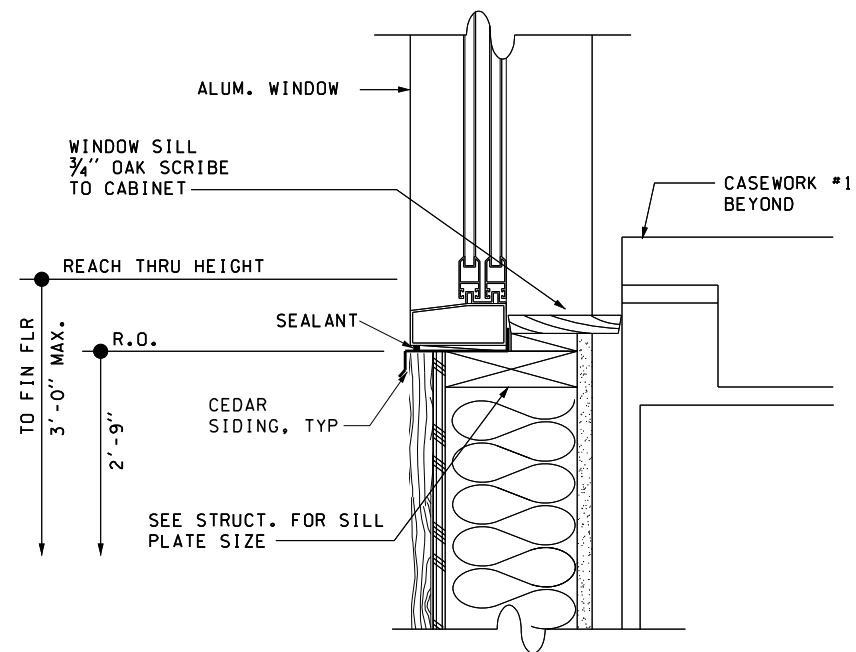


2 SELLER'S WINDOW SILL

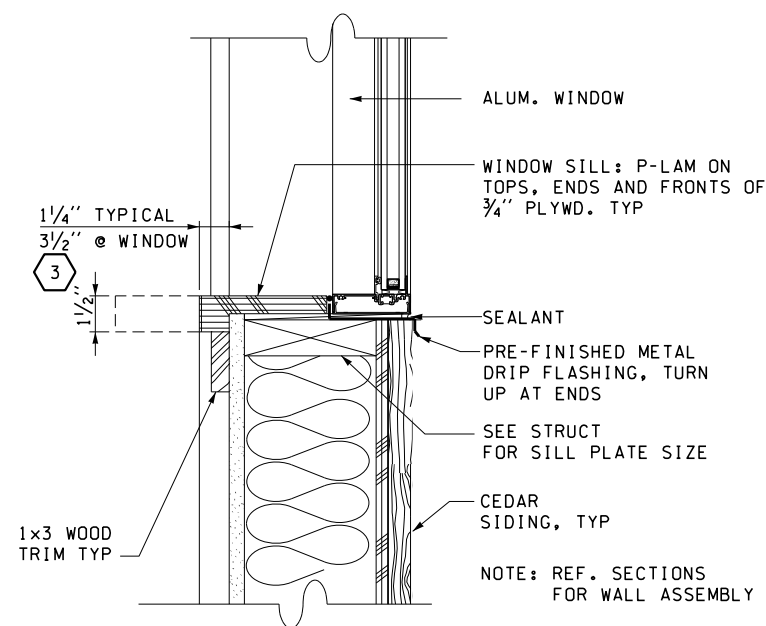

4 FIXED WINDOW SILL

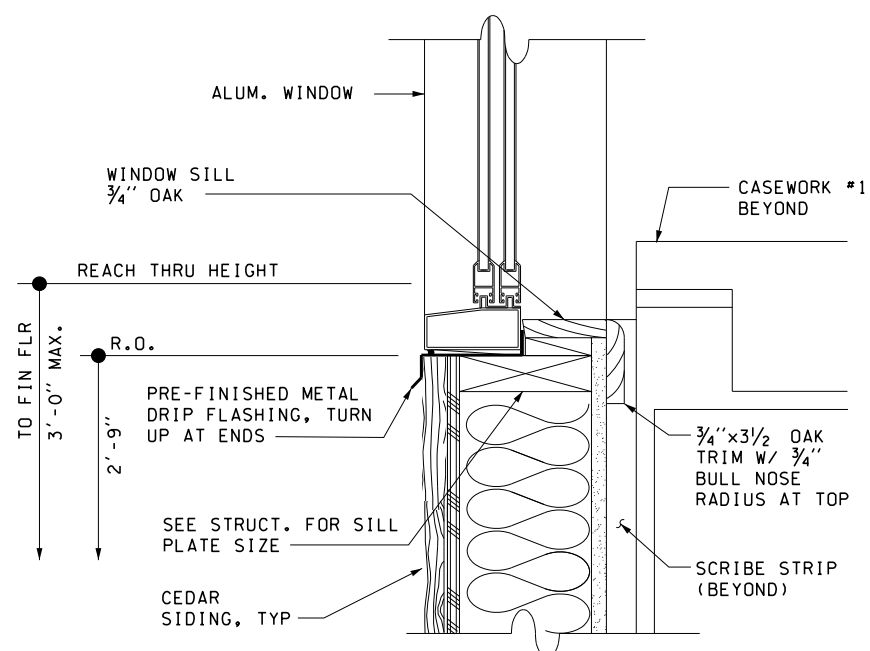

5 SELLER'S WINDOW SILL

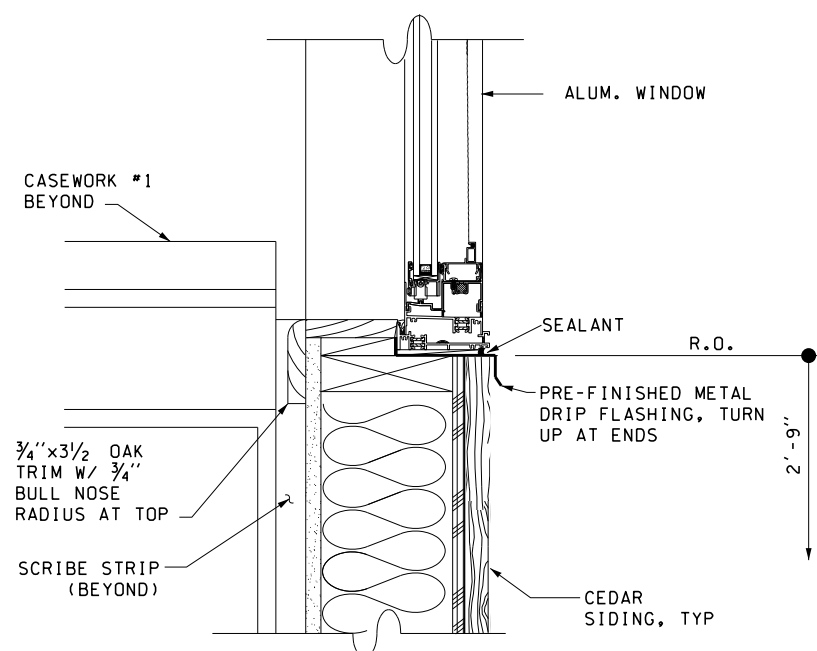

6 OPERABLE WINDOW SILL

FILE NAME: WSF\Mukilteo\14W121_FerryTermConst\CADD\WSF\ \$FILES\$					
PRINTED: 2:03:50 PM 9/21/2018	LAST PRINTED BY: Morin				FED.AID PROJ.NO.
SUBMITTAL DATE: 9/21/2018					WA-2017-007-00
DESIGNED BY: S. LEACH	9/21/2018				REGION NO. STATE
ENTERED BY: M. MORIN	9/21/2018				10 WASH
CHECKED BY: M. SCOTT	9/21/2018				JOB NUMBER
MAR PROJ ENGR: C. TORRES	9/21/2018				18W121
DIR TERM ENGR: N. MCINTOSH		ADDENDUM NO. 2	11/01/18		CONTRACT NO.
ASST SECRETARY: A. SCARTON		REVISION	DATE	BY	00*****




SR 525
MUKILTEO FERRY TERMINAL (PHASE 2)
FERRY TERMINAL CONSTRUCTION
WINDOW DETAILS

AX05.04
SHEET
1383
OF
1521
SHEETS

- NOTES:
- 1. CASEWORK FINISH TO BE P-LAM PER SPECIFICATION U.N.O.
 - 2. CASEWORK TO ALLOW A 2" CORD SLOT BEHIND FOR A TOTAL DEPTH OF 26 1/2".
 - 3. ALL EXPOSED FACES/ EDGES TO RECIEVE P-LAM U.N.O.
 - 4. COUNTERTOP TO EXTEND BETWEEN SILLS OF TRANSACTION WINDOWS; INSTALL SCRIBE STRIP. SEE DETAIL 2 AT CABINET AND DETAIL 3 IN FRONT OF CABINET.
 - 5. PROVIDE 12" WIDE REMOVEABLE FILLER TO MATCH PROFILE OF ADJACENT COUNTER. P-LAM OVER PLYWOOD W/ BULLNOSE OAK NOSING.

CASEWORK TABLE

TOLL BOOTH #	DIMENSION	
	A	B
1	55"	8"
2	55"	8"
3	55"	8"
4	87 3/4"	22 3/4"

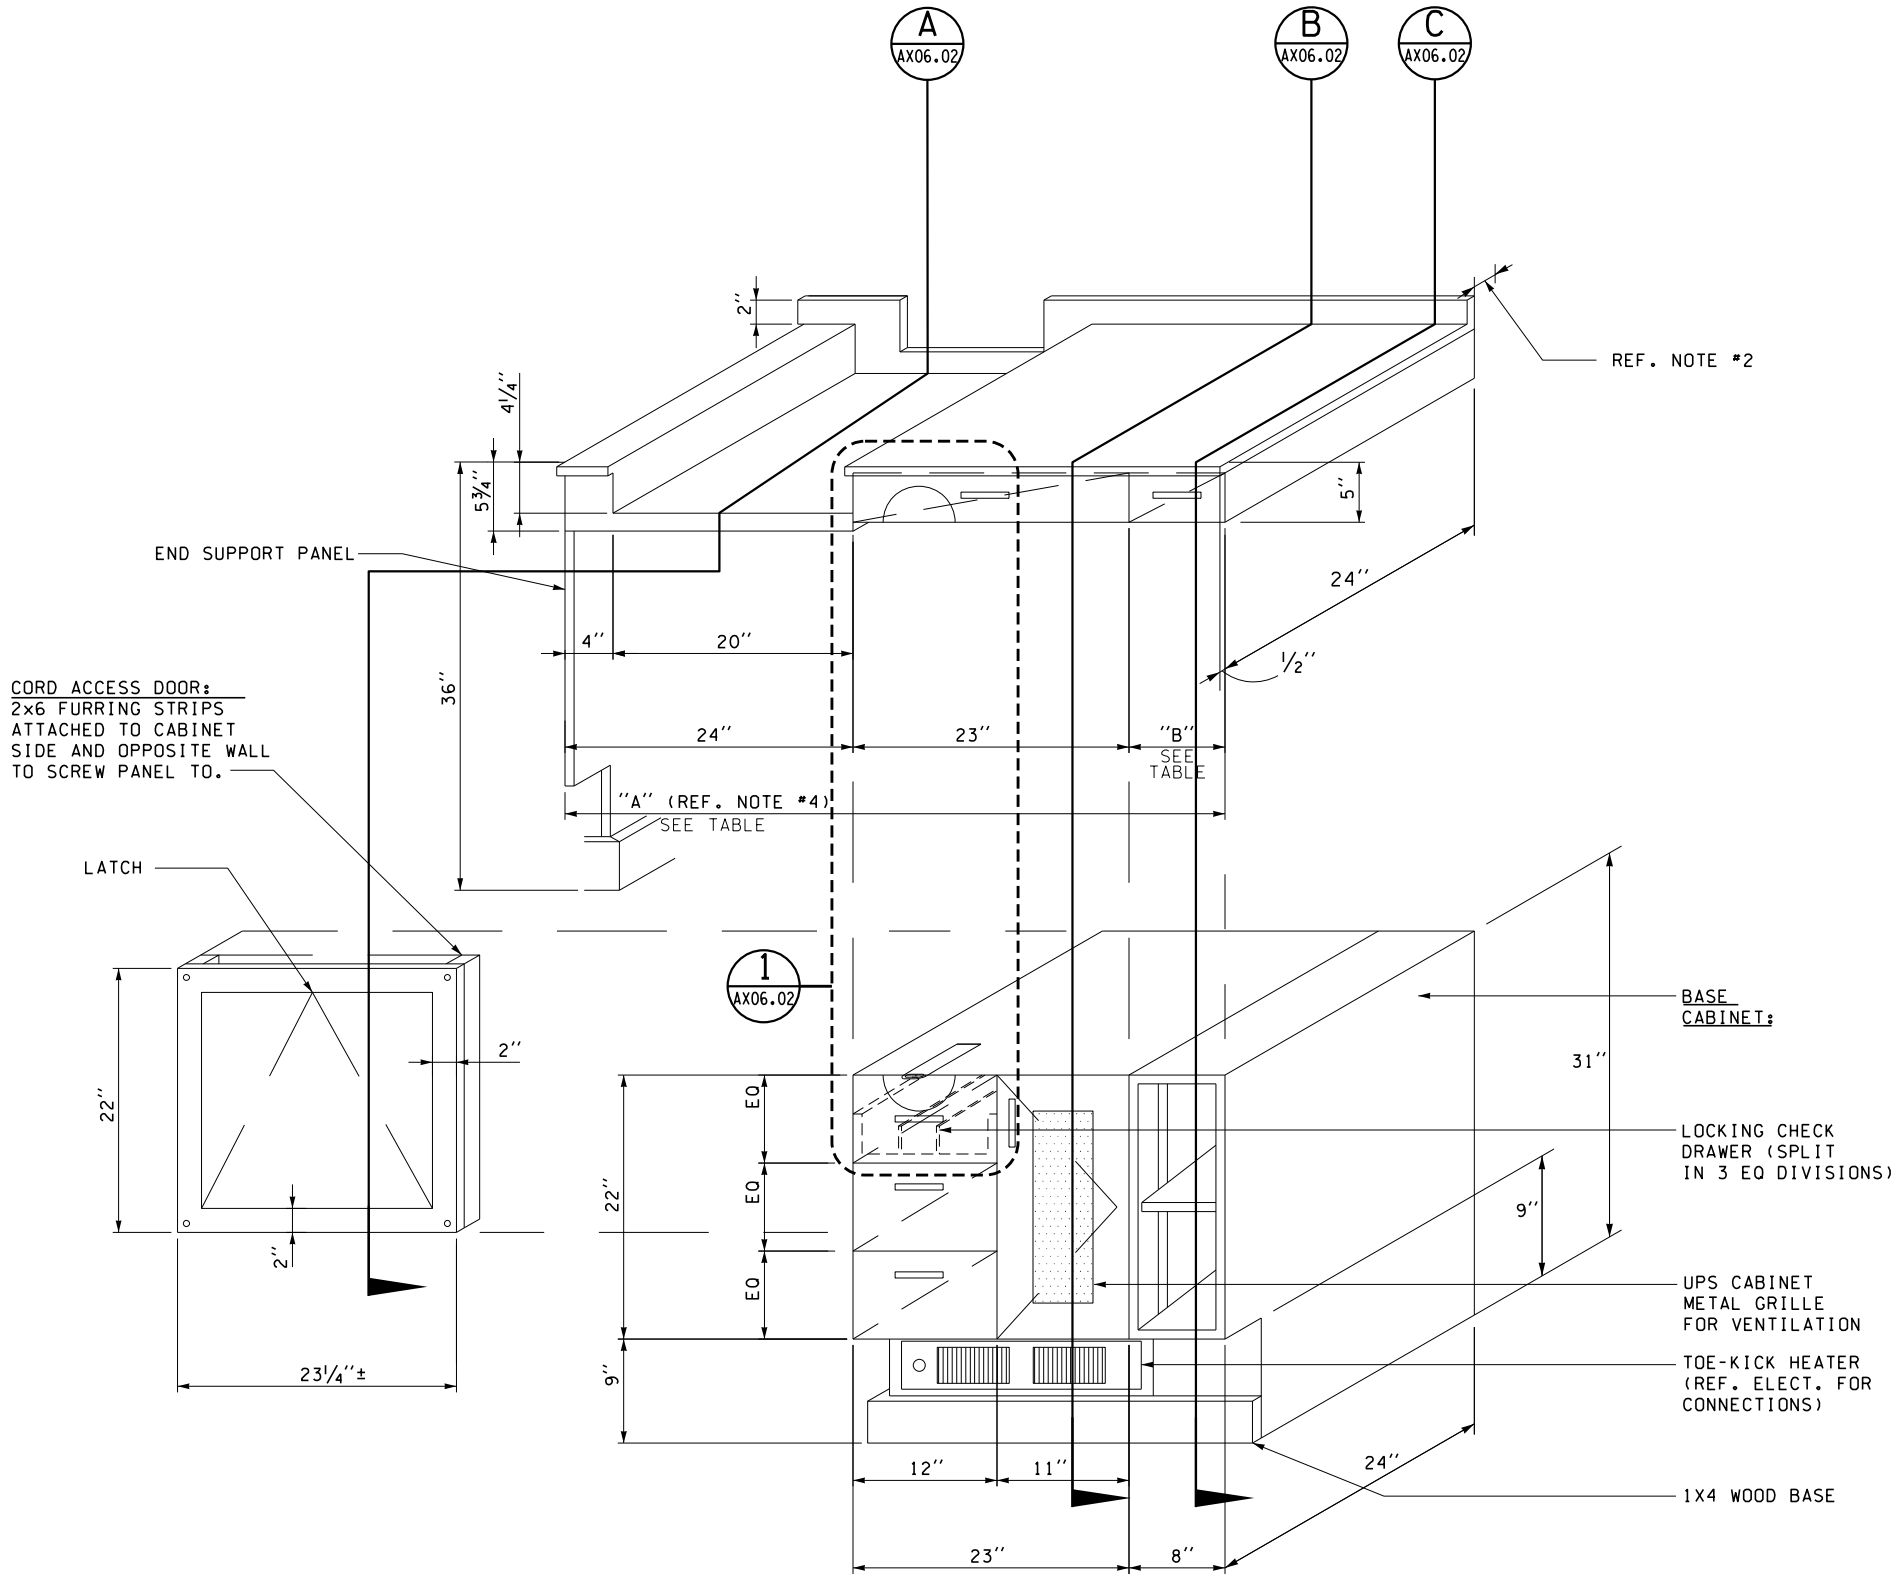

1 FRONT WALL CASEWORK #1 ISOMETRIC




FILE NAME: WSF\Mukilteo\14W121_FerryTermConst\CADD\WSF\ \$FILES\$				
PRINTED: 2:03:56 PM 9/21/2018	LAST PRINTED BY: Morin			FED.AID PROJ.NO. WA-2017-007-00
SUBMITTAL DATE: 9/21/2018				REGION NO. STATE 10 WASH
DESIGNED BY: S. LEACH	9/21/2018			JOB NUMBER 18W121
ENTERED BY: M. MORIN	9/21/2018			CONTRACT NO. 00****
CHECKED BY: M. SCOTT	9/21/2018			
MAR PROJ ENGR: C. TORRES	9/21/2018			
DIR TERM ENGR: N. MCINTOSH		ADDENDUM NO. 2	11/01/18	
ASST SECRETARY: A. SCARTON		REVISION	DATE	BY




SR 525
MUKILTEO FERRY TERMINAL (PHASE 2)
FERRY TERMINAL CONSTRUCTION
CASEWORK #1 DRAWINGS


AX06.01
SHEET 1384 OF 1521 SHEETS

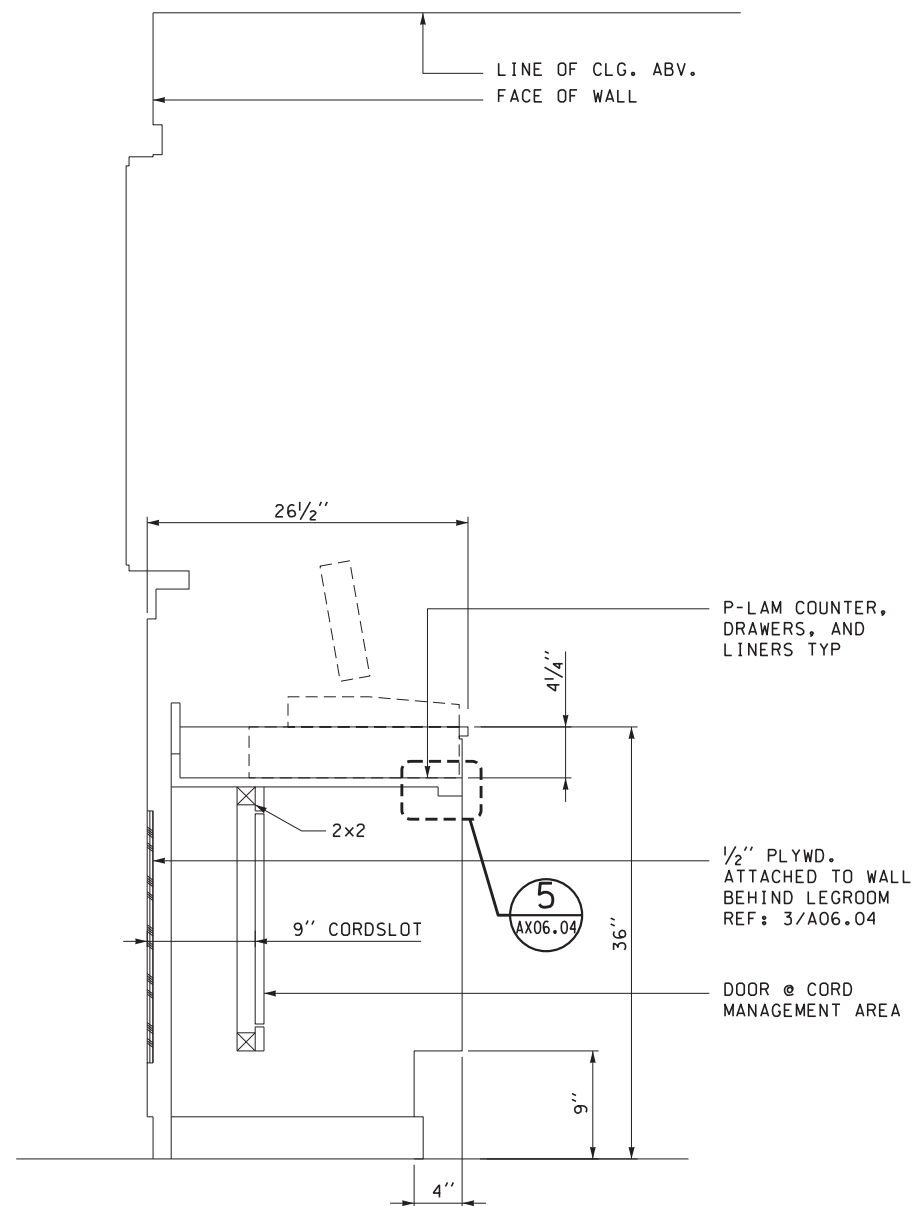

A SECTION-CASEWORK #1
THRU KNEE SPACE

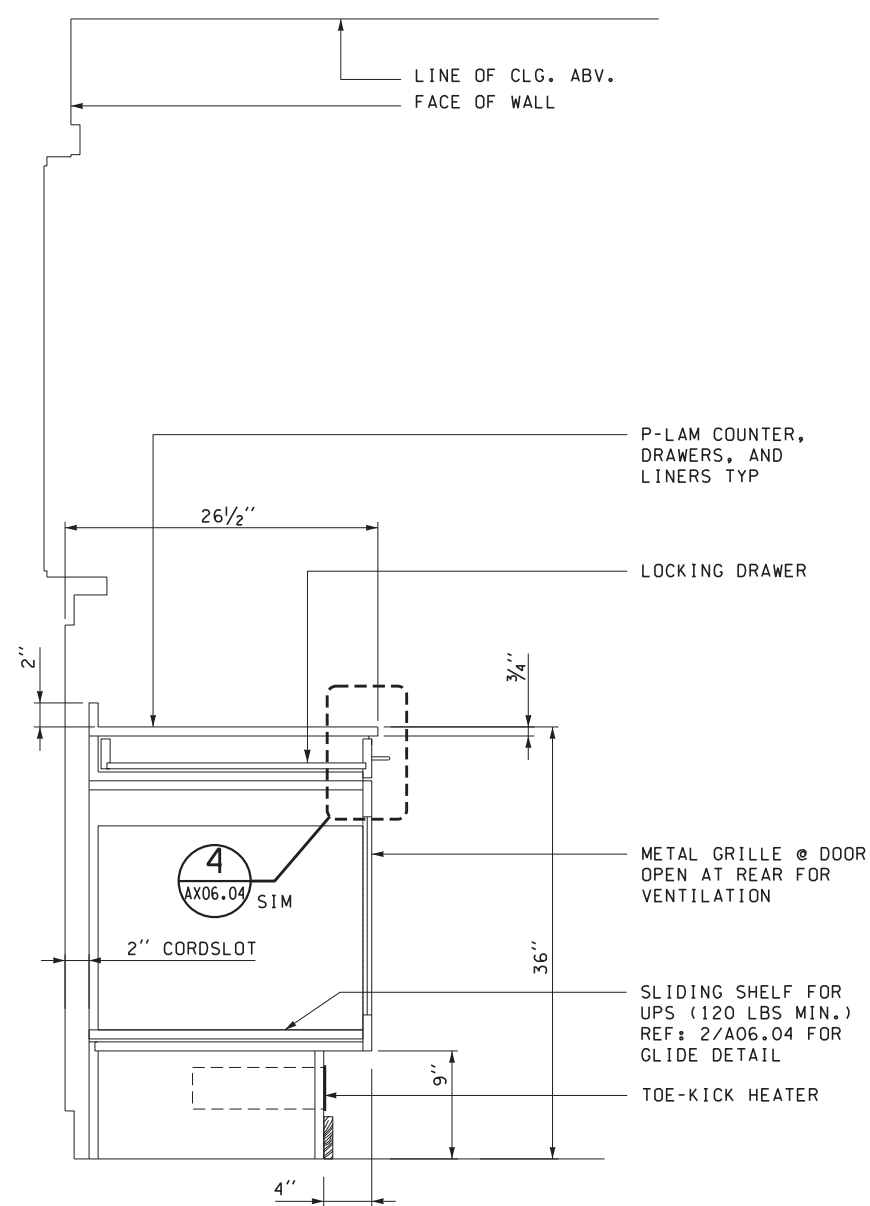

B SECTION-CASEWORK #1
THRU CABINET #1 & #2

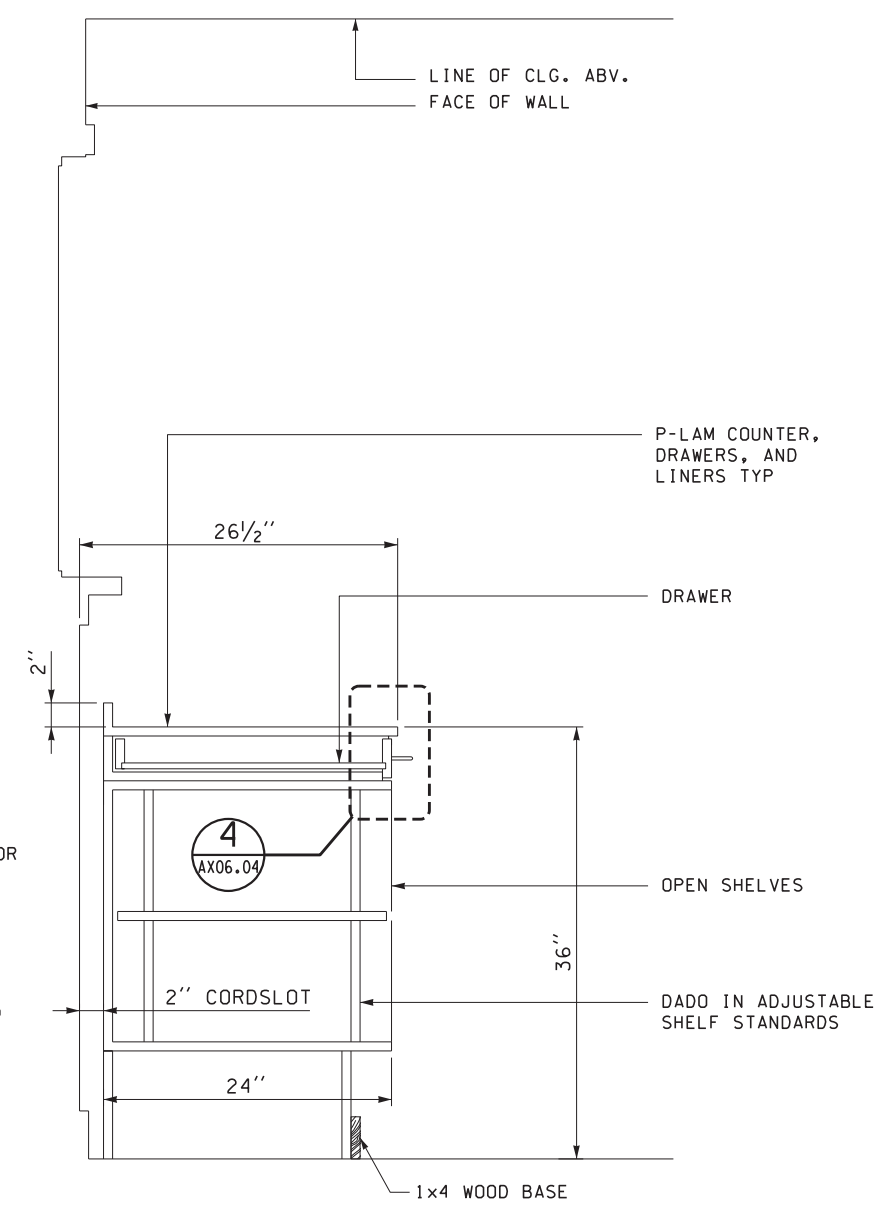

C SECTION-CASEWORK #1
THRU CABINET #1 & #3






FILE NAME: WSF\Mukilteo\14W121_FerryTermConst\CADD\WSF\ 14w121ax06_02.dwg					
PRINTED: 7:49:48 AM 2/23/2018	LAST PRINTED BY: Morin				FED.AID PROJ.NO.
SUBMITTAL DATE: 12/22/2017					WA-2017-007-00
DESIGNED BY: S. LEACH	12/22/2017				REGION NO. STATE
ENTERED BY: M. MORIN	12/22/2017				10 WASH
CHECKED BY: M. SCOTT	12/22/2017				JOB NUMBER
MAR PROJ ENGR: C. TORRES	12/22/2017	ADD ENTIRE SHEET			18W121
DIR TERM ENGR: N. MCINTOSH		ADDENDUM 2	10-31-2018		CONTRACT NO.
ASST SECRETARY: A. SCARTON		REVISION	DATE	BY	00****




SR 525
MUKILTEO FERRY TERMINAL (PHASE 2)
FERRY TERMINAL CONSTRUCTION
CASEWORK #1 SECTIONS

AX06.02
SHEET
1385
OF
1521
SHEETS

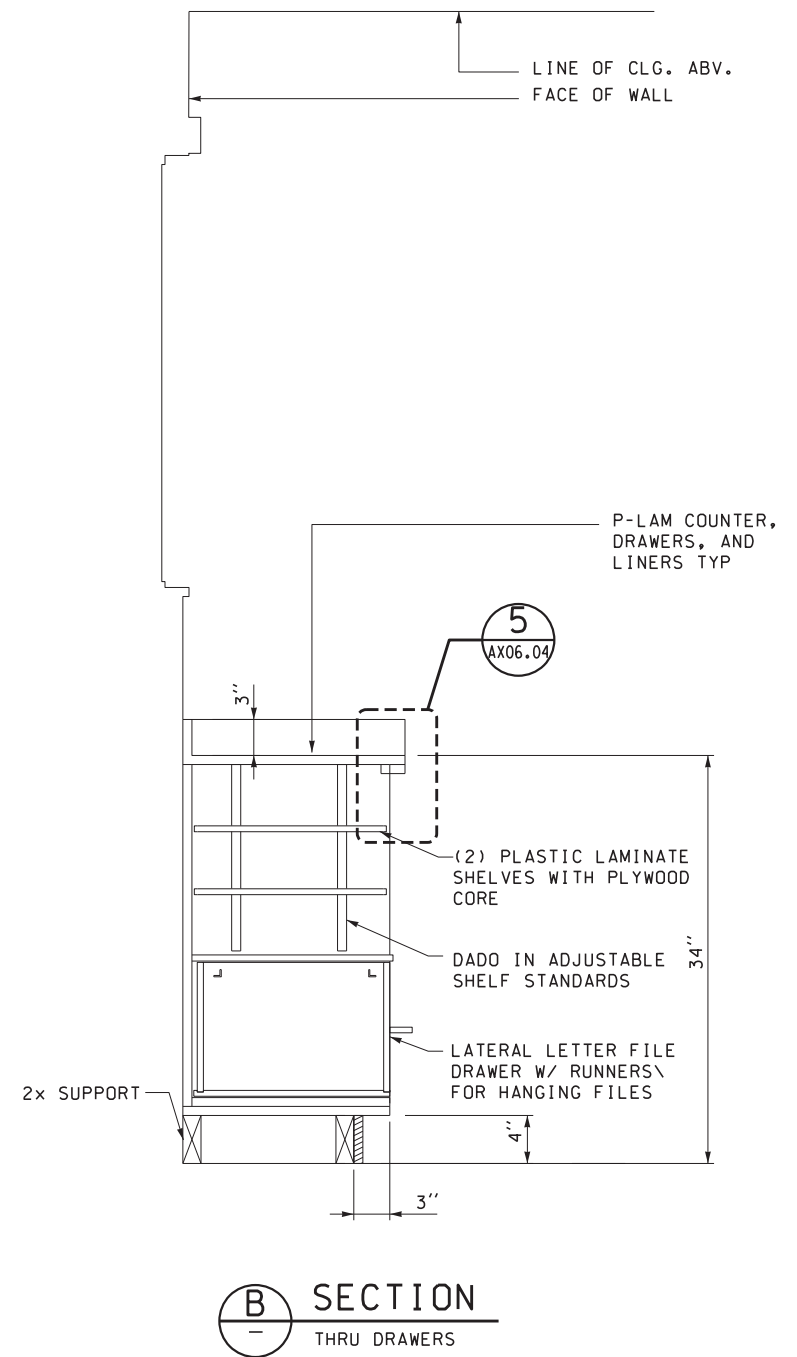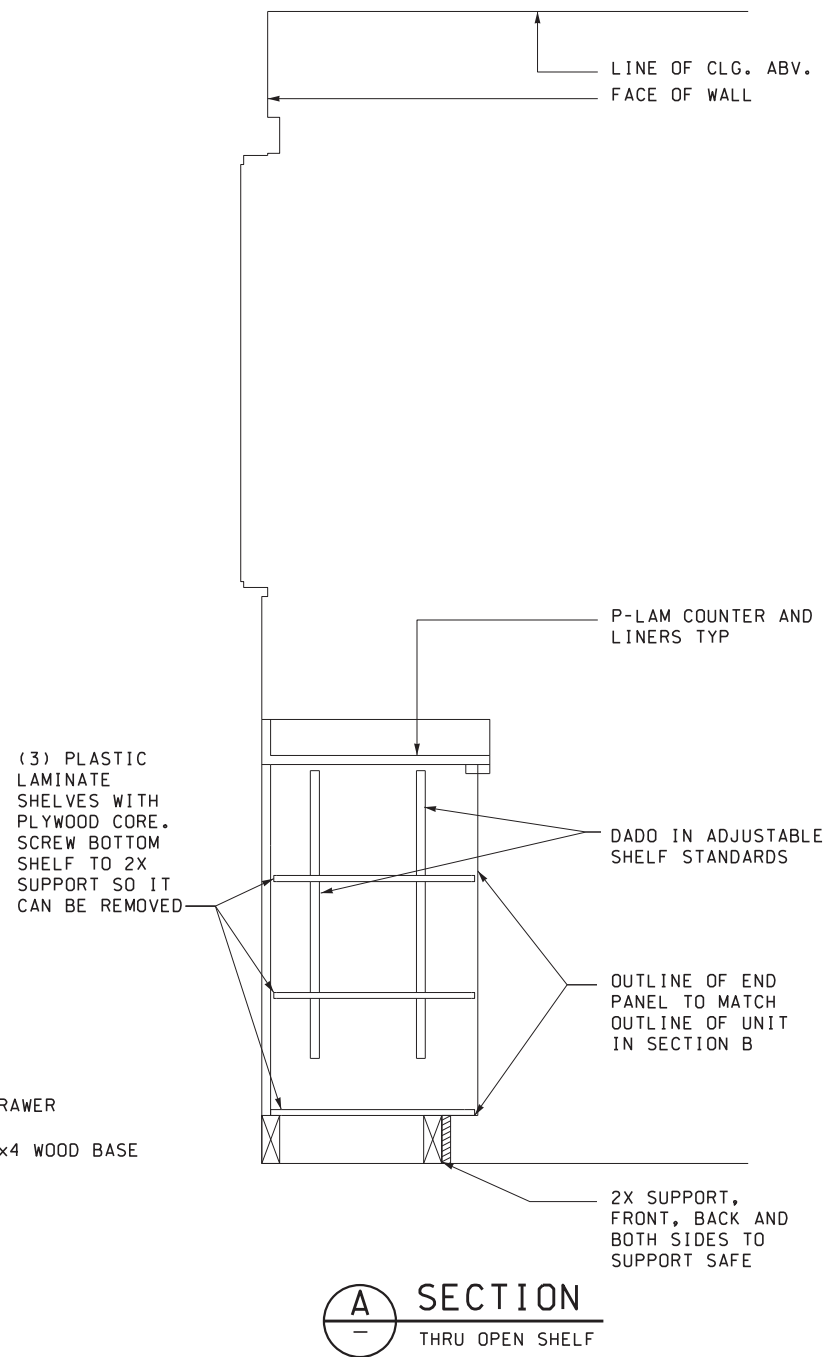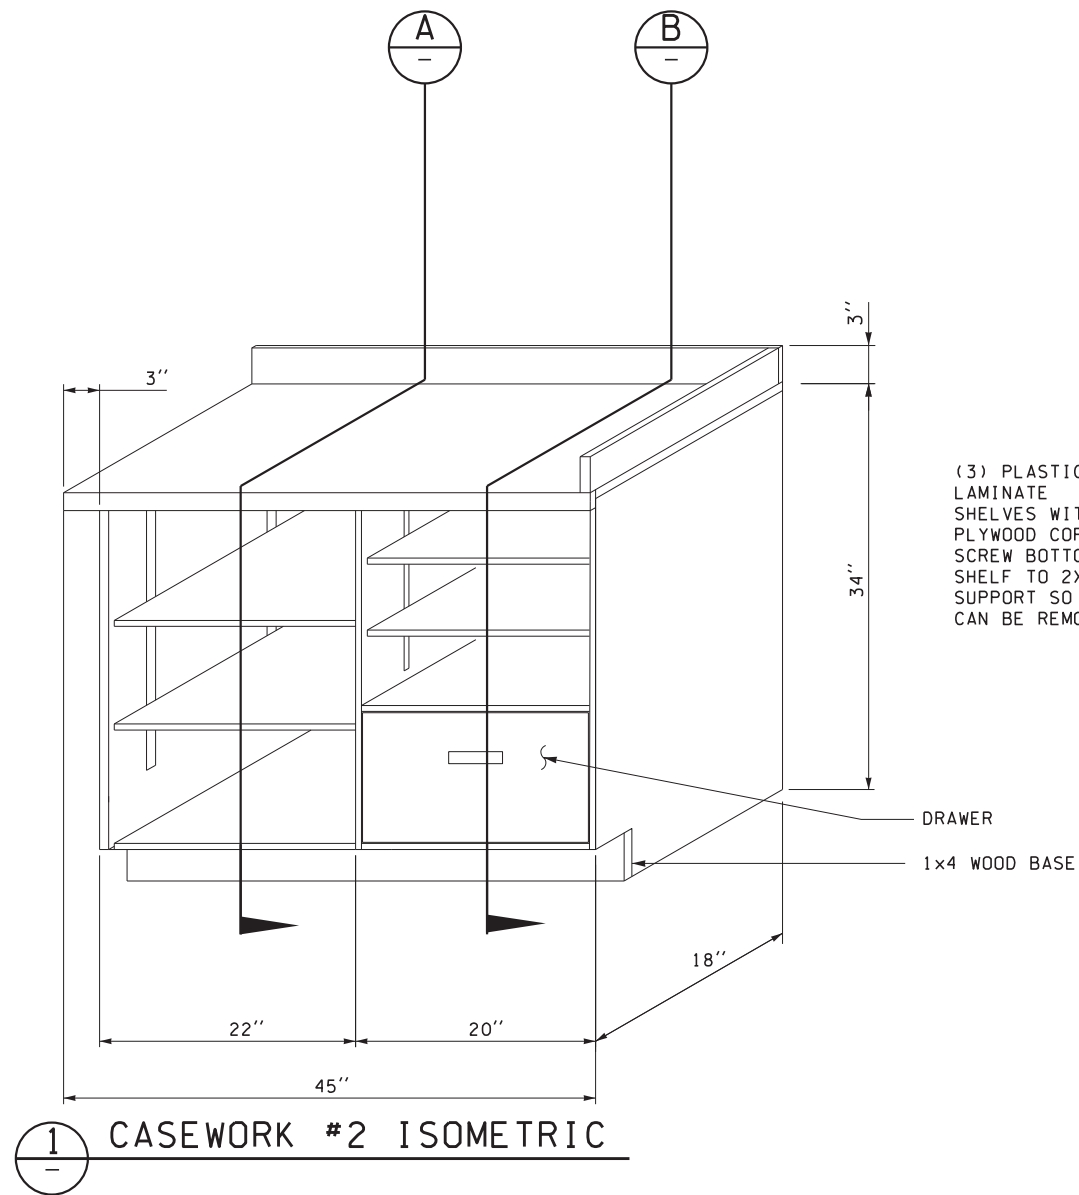

FILE NAME: WSF\Mukilteo\14W121_FerryTermConst\CADD\WSF\ \$FILES\$					
PRINTED: 2:04:02 PM 9/21/2018	LAST PRINTED BY: Morin				FED.AID PROJ.NO.
SUBMITTAL DATE: 9/21/2018					WA-2017-007-00
DESIGNED BY: S. LEACH	9/21/2018				REGION NO. STATE
ENTERED BY: M. MORIN	9/21/2018				10 WASH
CHECKED BY: M. SCOTT	9/21/2018				JOB NUMBER
MAR PROJ ENGR: C. TORRES	9/21/2018				18W121
DIR TERM ENGR: N. MCINTOSH					CONTRACT NO.
ASST SECRETARY: A. SCARTON					00****
	REVISION	DATE	BY		

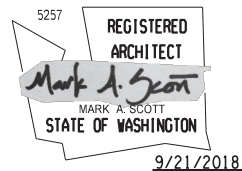


SR 525
MUKILTEO FERRY TERMINAL (PHASE 2)
FERRY TERMINAL CONSTRUCTION

CASEWORK #2 DRAWINGS


AX06.03

SHEET
1386
OF
1521
SHEETS

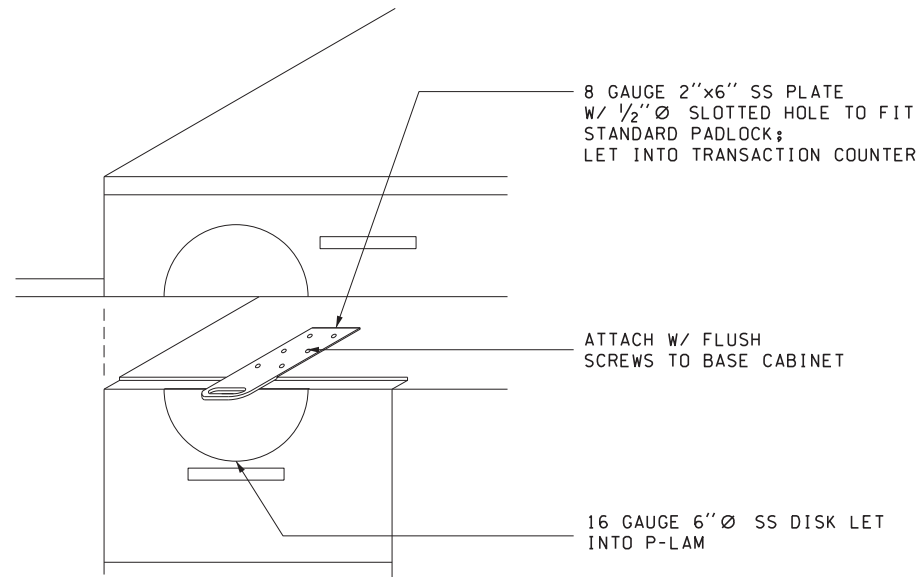


1 LOCKING DRAWER

0 3 6 1 1/2

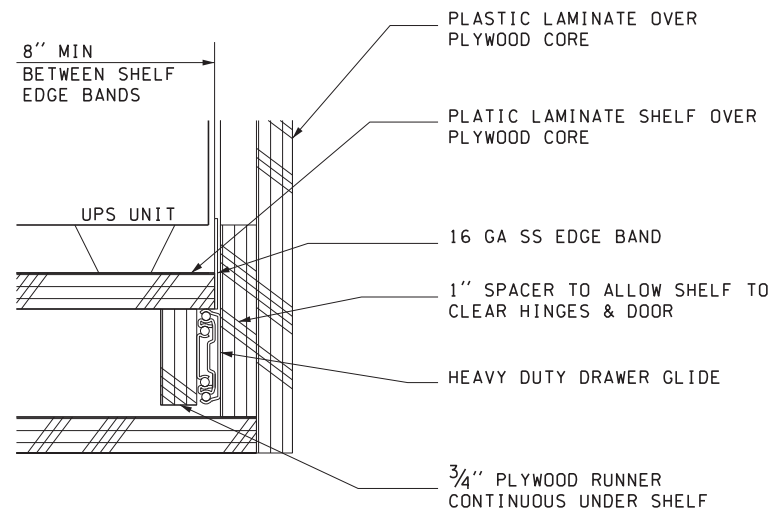


2 UPS SHELF GLIDE

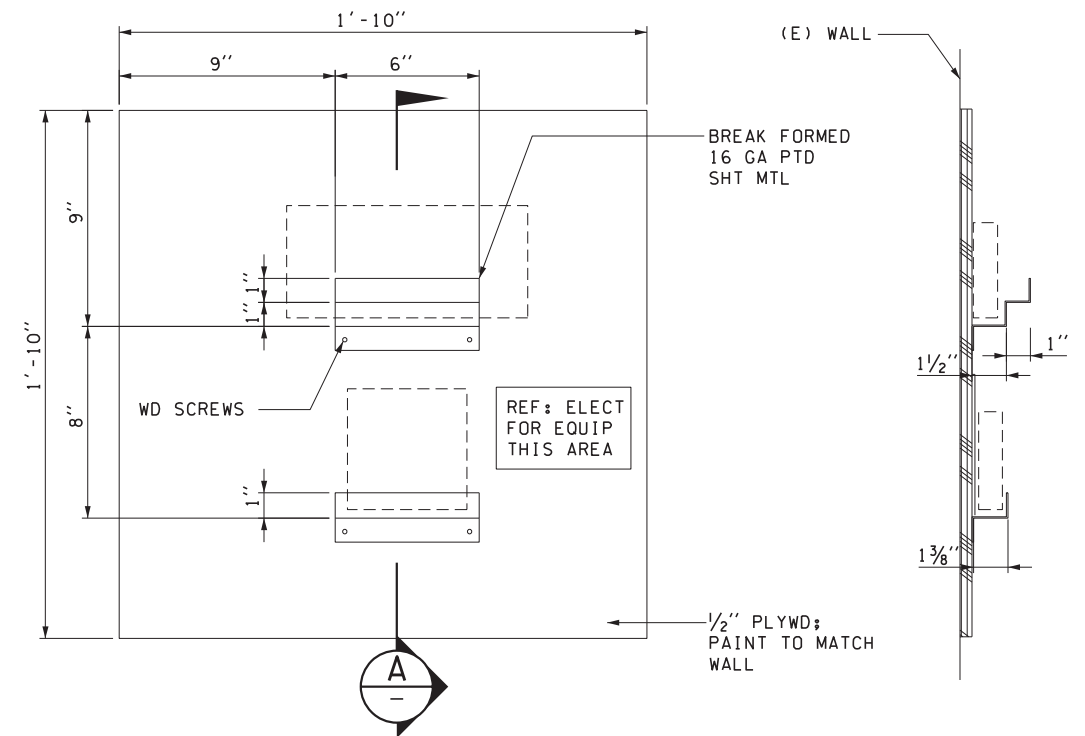


3 PLYWOOD WALL

0 3 6 1 1/2


A SECTION

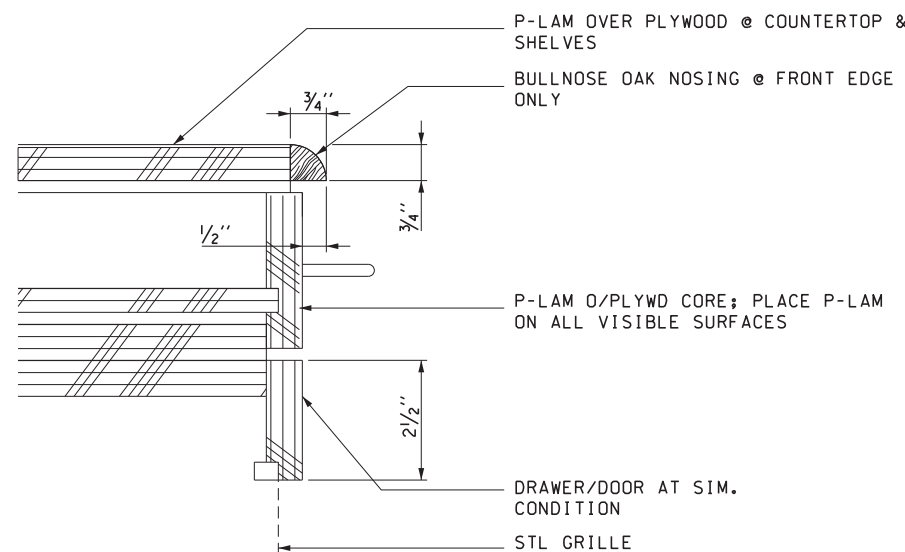

4 DRAWER DETAIL

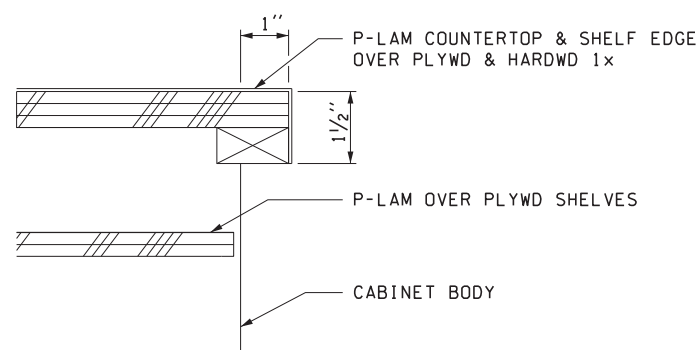


5 COUNTER EDGE DETAIL

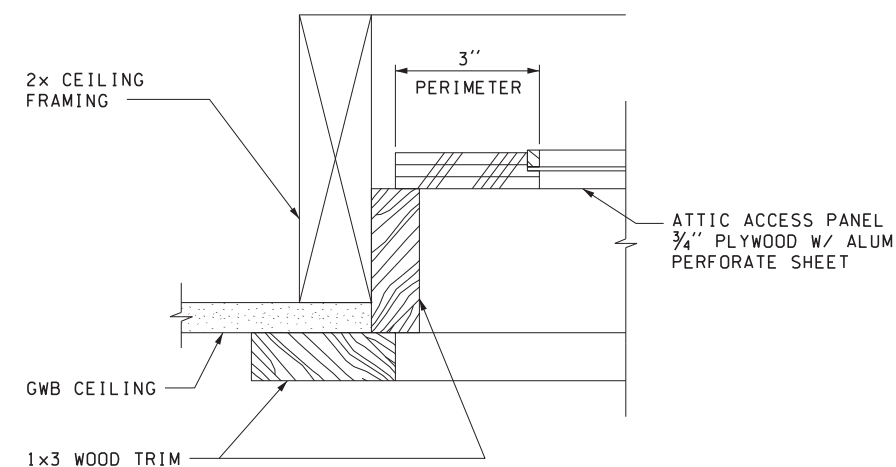

6 ATTIC ACCESS PANEL

0 2 4 3

FILE NAME: WSF\Mukilteo\14W121_FerryTermConst\CADD\WSF\ \$FILES\$					
PRINTED: 2:04:08 PM 9/21/2018	LAST PRINTED BY: Morin				FED.AID PROJ.NO. WA-2017-007-00
SUBMITTAL DATE: 9/21/2018					REGION NO. STATE 10 WASH
DESIGNED BY: S. LEACH	9/21/2018				JOB NUMBER 18W121
ENTERED BY: M. MORIN	9/21/2018				CONTRACT NO. 00****
CHECKED BY: M. SCOTT	9/21/2018				
MAR PROJ ENGR: C. TORRES	9/21/2018				
DIR TERM ENGR: N. MCINTOSH					
ASST SECRETARY: A. SCARTON		REVISION	DATE	BY	

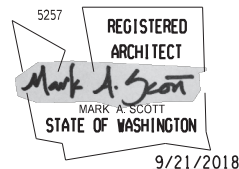

SR 525
MUKILTEO FERRY TERMINAL (PHASE 2)
FERRY TERMINAL CONSTRUCTION
DETAILS


AX06.04
SHEET 1387 OF 1521 SHEETS


STRUCTURAL ABBREVIATIONS


AND	CJP, CP	COMPLETE JOINT PENETRATION	EMBED	EMBEDMENT	IF	INSIDE FACE	OC	ON CENTER	SPEC	SPECIFICATION
ANCHOR BOLT	CL	CENTERLINE	ENCR	ENGINEER	IN	INCH	OD	OUTSIDE DIAMETER	SO	SQUARE
AMERICAN CONCRETE INSTITUTE	CLR	CLEAR	EQ	EARTHQUAKE, EQUAL	INCL	INCLUDE	OF	OUTSIDE FACE	SST	STAINLESS STEEL
ADDITIONAL	COL	COLUMN	EQUIP	EQUIPMENT	INFO	INFORMATION	OPNG	OPENING	SSH	SHORT SLOTTED HOLE
ADJACENT, ADJUSTABLE	CONC	CONCRETE	ES	EACH SIDE	INT	INTERIOR	OPP	OPPOSITE	STAG	STAGGER, STAGGERED
AMERICAN INSTITUTE OF	CONN	CONNECTION	ETC	ET CETERA	IJ	ISOLATION JOINT	OSH	OVERSIZED HOLE	STD	STANDARD
STEEL CONSTRUCTION	CONST	CONSTRUCTION	E-W	EAST-WEST	JST	JOIST			STIF	STIFFENER
	CONT	CONTINUE, CONTINUOUS	EW	EACH WAY	JT	JOINT			STIR	STIRRUP
	CONTR	CONTRACTOR	EXP	EXPANSION					STL	STEEL
	COORD	COORDINATE	EXT	EXTERIOR					STRUCT	STRUCTURAL
	CRSI	CONCRETE REINFORCED	EXT GR	EXTERIOR GRADE	K	KIP (1,000 LB)	PCC	PRECAST CONCRETE	SPRT	SUPPORT
ALTERNATE		STEEL INSTITUTE			KSF	KIPS PER SQUARE FOOT	PCF	POUNDS PER CUBIC FOOT	PEN	PENETRATION
ANCHOR	CTR	CENTER, CENTERED	FD	FLOOR DRAIN	KSJ	KIPS PER SQUARE INCH	PEN	PENETRATION	PERP	PERPENDICULAR
AMERICAN PLYWOOD ASSOCIATION	CU YD	CUBIC YARD	FDN	FOUNDATION			PL	PLATE, PROPERTY LINE	PLCS	PLACES
APPROXIMATE					L	LENGTH, ANGLE	PLF	POUNDS PER LINEAR FOOT	T/	TOP OF
ANCHOR ROD					LB	POUND	PLWD	PLYWOOD	T&B	TOP AND BOTTOM
ARCHITECT, ARCHITECTURAL					LEV	LEVEL	PNL	PANEL	T&G	TONGUE AND GROOVE
AMERICAN SOCIETY OF					LF	LINEAL FOOT	PP, PJP	PARTIAL JOINT PENETRATION	TC	TOP CHORD
CIVIL ENGINEERS	d	PENNYWEIGHT (NAILS)	FF	FAR FACE, FINISH FLOOR	LL	LIVE LOAD	PREFAB	PREFABRICATED	TEMP	TEMPERATURE
AMERICAN SOCIETY FOR	DB	DIVIDER BEAM, DROPPED BEAM	FIN	FINISH	LLBB	LONG LEGS BACK TO BACK	PSF	POUNDS PER SQUARE FOOT	THK	THICK, THICKNESS
TESTING AND MATERIALS	D-B	DESIGN-BUILD	FLR	FLOOR	FS	LONG LEG HORIZONTAL	PT	POINT, PRESSURE TREATED	THRU	THROUGH
AMERICAN WELDING SOCIETY	DBA	DEFORMED BAR ANCHOR	FLG	FLANGE	LLV	LONG LEG VERTICAL	PSI	POUNDS PER SQUARE INCH	TOC	TOP OF CONCRETE
	DBL	DOUBLE	FT	FAR SIDE	LOC	LOCATION, LOCATE	PVC	POLYVINYL CHLORIDE	TOF	TOP OF FOOTING
	DEG	DEGREE	FTG	FEET	LONGIT	LONGITUDINAL			TOW	TOP OF WALL
BOTTOM OF	DEMO	DEMOLISH, DEMOLITION		FOOTING	LPT	LOW POINT			TR	THREADED ROD
BALANCE	DET	DETAIL			LSH	LONG SLOTTED HOLE			TRANS	TRANSVERSE
BOTTOM CHORD	DIA	DIAMETER	GA	GAGE, GAUGE	LSL	LAMINATED STRAND LUMBER			TYP	TYPICAL
BRACED FRAME, BOTTOM FLANGE	DIAG	DIAGONAL	GALV	GALVANIZED			R, RAD	RADIUS	TWS	THREADED WELDED STUD
BUILDING	DIAPH	DIAPHRAGM	GB, GR BM	GRADE BEAM			REBAR	REINFORCING STEEL BARS		
BLOCKING	DICA	DRILLED-IN CONCRETE ANCHOR	GEN	GENERAL			REF	REFERENCE		
BEAM	DIM	DIMENSION	GL	GLUE LAMINATED WOOD	MATL	MATERIAL	REINF	REINFORCING		
BOTTOM OF FOOTING	DIST	DISTANCE	GLB	GLUE LAMINATED BEAM	MAX	MAXIMUM	REM	REMAINDER		
BOTTOM	DL	DEAD LOAD	GRD	GIRDER	MB	MACHINE BOLT	REOD	REQUIRED	UNO	UNLESS NOTED OTHERWISE
BASE PLATE	DN	DOWN	GRND	GROUND	MECH	MECHANICAL	RTN	RETURN	VERT	VERTICAL
BEARING	DO	DITTO	HDR	HEADER	MFR	MANUFACTURER				
BETWEEN	DP	DEEP	HGR	HANGER	MIN	MINIMUM				
BUILT-UP	DS	DRAG STRUT	HK	HOOK	MISC	MISCELLANEOUS				
	DWL	DRAWING	HLDN	HOLD DOWN	MTL	METAL				
		DOWEL	HORIZ	HORIZONTAL			SCHED	SCHEDULE	W	WIDTH, WIDE FLANGE
CAMBER, CHANNEL	(E)	EXISTING	HPT	HIGH POINT	NF	NEAR FACE	SECT	SECTION	W/	WITH
CONCRETE (EXPANSION) ANCHOR	EA	EACH	HSB	HIGH STRENGTH BOLT	NLG	NAILING	SHT	SHEET	WD	WOOD
CANTILEVER		EPOXY (ADHESIVE) ANCHOR	HSS	HOLLOW STRUCTURAL SECTION	NOM	NOMINAL	SHTHG	SHEATHING	WHS	WELDED HEADED STUD
CAPACITY		EACH END	HT	HEIGHT	NO	NUMBER	SIM	SIMILAR	W/O	WITHOUT
CENTER-TO-CENTER	EE	EACH FACE			N-S	NORTH-SOUTH	SOG	SLAB ON GRADE	WP	WORK POINT
CENTER OF GRAVITY	EF	EXPANSION JOINT	IBC	INTERNATIONAL BUILDING CODE	NS	NEAR SIDE	SPC	SPACE, SPACED, SPACING	WT	WEIGHT
CAST-IN-PLACE	EJ	ELEVATION	ID	INSIDE DIAMETER	NTS	NOT TO SCALE			WWF	WELDED WIRE FABRIC
CONTROL JOINT,	EL	ELECTRICAL								
CONSTRUCTION JOINT	ELEC									


STRUCTURAL SYMBOLS


GENERAL SYMBOLS


 GRID BUBBLE


 GRID LINE


 NORTH ARROW

 SOIL


 GRAVEL

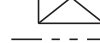
 OPENING IN FLOOR OR WALL

 MATCHLINE



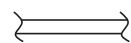

 REFERENCE LINE, EXISTING OR ARCHITECTURAL ELEMENTS

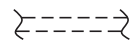CONCRETE SYMBOLS


 CONCRETE CURB/PARTIAL HEIGHT WALL


 CONCRETE WALL BELOW THIS LEVEL


CONNECTORS


PLAN	SECTION	
+		CONCRETE ANCHOR BOLT
+		DRILLED IN CONCRETE ANCHOR
+		BOLT
+		NAIL


DETAIL IDENTIFIERS

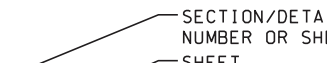
 SECTION/DETAIL/ELEVATION NUMBER OR SHEET

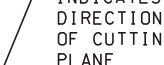
 INDICATES DIRECTION OF CUTTING PLANE

 TEXT NOTATION


 SECTION


 ELEVATION


 DETAIL


 REAR ELEVATION


WOOD SYMBOLS


 DIRECTION OF BEAMS, JOISTS OR TRUSSES

 
 EXTEND OF NONTYPICAL BEAMS, JOISTS OR TRUSSES


 CANTILEVERED END OF JOIST OR TRUSS


 BEAMS, GIRDERS OR HEADERS


 CANTILEVERED END OF BEAM, GIRDER OR HEADER


 POST OR COLUMN BELOW THIS LEVEL


 CONTINUOUS FRAMING MEMBER


 BLOCKING OR NONCONTINUOUS FRAMING MEMBER


 INDICATES BEAM, GIRDER OR HEADER CONTINUOUS OVER SUPPORT


 INDICATES BEAM, GIRDER OR HEADER NOT CONTINUOUS OVER SUPPORT


 LINE OF ROOF RIDGE, HIP, VALLEY, EDGE OF GABLE END OR OVERHANG

 OVERFRAMING BY TRUSS MANUFACTURER

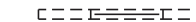
 SHEATHING ON THIS FACE


 SHEAR WALL


 HEADER BELOW THIS LEVEL


 HOLD DOWN


WOOD FRAMING ANNOTATIONS


 WOOD CAP MARK


 WOOD POST MARK


 BEAM HANGER MARK

 BEAM MARK

 SHEAR WALL MARK

 WOOD STRAP MARK

 WOOD BASE MARK

 HOLD DOWN MARK

GENERAL

ALL TYPICAL DETAILS AND NOTES SHOWN ON THESE DRAWINGS ARE PART OF THE CONSTRUCTION CONTRACT AND SHALL BE PROVIDED BY THE CONTRACTOR. TYPICAL DETAILS MAY NOT NECESSARILY BE INDICATED ON THE PLANS, BUT SHALL APPLY AS SHOWN OR DESCRIBED IN THE DETAILS.

CODES

BUILDING CODE: ALL MATERIALS, WORKMANSHIP, DESIGN, AND CONSTRUCTION SHALL CONFORM TO THE DRAWINGS, SPECIFICATIONS, AND THE INTERNATIONAL BUILDING CODE (IBC), 2015 EDITION, AS AMENDED BY SNOHOMISH COUNTY.

STANDARDS: REFERENCE TO ASTM AND OTHER STANDARDS SHALL MEAN THE LATEST EDITION IN EFFECT ON THE BID DATE, UNLESS NOTED IN THESE DOCUMENTS OR DESIGNATED BY THE GOVERNING CODE.

LOADS

FLOOR DESIGN DATA

IN ADDITION TO THE SELF WEIGHT, THE FOLLOWING LOADS ARE USED FOR DESIGN:

	UNIFORM LIVE LOAD (PSF)	CONCENTRATED LIVE LOAD (KIPS)	SUPERIMPOSED DEAD LOAD (PSF)	REDUCIBLE (SEE NOTE)
FLOOR	50	300	-	NO
CEILING	20	300	-	NO
ROOF	20	300	-	NO

SNOW DESIGN DATA:

SNOW LOAD = 20 PSF

WIND DESIGN DATA:

WIND BASE SHEAR:
LONG = 1.7 KIPS
TRANS = 3.8 KIPS
ANALYTICAL PROCEDURE = DIRECTIONAL PROCEDURE, ASCE 7 CHAPTER 27
ENCLOSURE CLASSIFICATION = ENCLOSED (ASCE 7 SECTION 26.10)
TYPE OF STRUCTURE = RIGID (ASCE 7 SECTION 26.2)
BASIC WIND SPEED V_{3s} = 100 MPH, 3 SECOND GUST (ASCE 7 FIGURE 26.5-1C)
EXPOSURE CATEGORY = D (ASCE 7 SECTION 26.7)

DIRECTIONALITY FACTOR K_d = 0.85 : MWFRS, COMPONENTS AND CLADDING (ASCE 7 TABLE 26.6-1)
TOPOGRAPHIC FACTOR K_{zt} = 1.0 (ASCE 7 SECTION 26.8)
GUST EFFECT FACTOR G = 0.85 (ASCE 7 SECTION 26.9.1)

EARTHOUAKE DESIGN DATA:

BASIC SEISMIC-FORCE-RESISTING SYSTEM: BEARING WALL SYSTEM (N-S)
BEARING WALL SYSTEM (E-W)
EQUIVALENT LATERAL FORCE PROCEDURE

ANALYTICAL PROCEDURE: V_E = 1.4 KIPS
SEISMIC BASE SHEAR: (ASCE 7 SECTION 12.8.1)
SEISMIC RESPONSE COEFFICIENT: Cs = 0.15 (ASCE 7 SECTION 12.8.1.1)

SEISMIC IMPORTANCE FACTOR I_E = 1.0 (OCCUPANCY CATEGORY [I], ASCE 7 SECTION 11.5.1)

SITE CLASS = D (ASCE 7 SECTION 11.4.2)
S_s = 1.47 (ASCE 7 SECTION 11.4.1)
S_i = 0.57 (ASCE 7 SECTION 11.4.1)
S_{0s} = 0.98 (ASCE 7 SECTION 11.4.4)
S_{0i} = 0.57 (ASCE 7 SECTION 11.4.4)
SEISMIC DESIGN CATEGORY = D (ASCE 7 SECTION 11.6)
RESPONSE MODIFICATION COEFFICIENT R = 6.5 (ASCE 7 TABLE 12.2-1)

WOOD

REFERENCE STANDARDS: WOOD SHALL CONFORM TO ALL REQUIREMENTS OF THE FOLLOWING DOCUMENTS:

AITC	"TIMBER CONSTRUCTION MANUAL"
NDS	"NATIONAL DESIGN SPECIFICATION FOR WOOD CONSTRUCTION"
AF AND PA SDPWS	"SUPPLEMENT SPECIAL DESIGN PROVISIONS FOR WIND AND SEISMIC"
ANSI A190.1	"STANDARD FOR STRUCTURAL GLUED LAMINATED TIMBER"
ANSI A117	"STANDARD SPECIFICATIONS FOR STRUCTURAL GLUED LAMINATED TIMBER OF SOFTWOOD SPECIES"
TPI 1	"NATIONAL DESIGN STANDARD FOR METAL PLATE CONNECTED WOOD TRUSS CONSTRUCTION"

PLYWOOD: WOOD STRUCTURAL PANELS SHALL CONFORM TO REQUIREMENTS OF US DEPARTMENT OF COMMERCE PS 1 OR PS 2. EACH PANEL SHALL BEAR THE AMERICAN PLYWOOD ASSOCIATION (APA) GRADE MARK. SEE DRAWINGS FOR GRADE AND THICKNESS.

SHEATHING: UNLESS NOTED OTHERWISE, ROOF AND FLOOR PANELS SHALL BE INSTALLED WITH LONG DIMENSION PERPENDICULAR TO SUPPORTS AND CONTINUOUS OVER 2 OR MORE SPANS. PLACE NAILS 3/8" FROM PANEL ENDS AND EDGES. DRIVE ALL NAILS FLUSH WITH SHEATHING SURFACE. BLOCK ALL WALL AND DIAPHRAGM EDGES. BLOCKED SHEARWALL EDGES SHALL USE 2x FRAMING. MINIMUM NAIL PENETRATION INTO SUPPORTS SHALL BE 1 1/2".

SAWN LUMBER: SAWN LUMBER SHALL BE IDENTIFIED BY THE GRADE MARK OF A LUMBER GRADING OR INSPECTION AGENCY APPROVED BY AN ACCREDITATION BODY COMPLYING WITH US DEPARTMENT OF COMMERCE PS 20. SAWN LUMBER SPECIES AND GRADES SHALL BE AS FOLLOWS EXCEPT WHERE NOTED IN THE DRAWINGS:

USE	SIZE	SPECIES	GRADE
WALL STUDS	2x 3x	HEM-FIR	#2
SILL PLATES	2x 3x	HEM-FIR	UTILITY
JOISTS	2x	HEM-FIR	#2
CURB FRAMING	6x	HEM-FIR	#2

CONNECTORS: DESIGN SHOWN ON DRAWINGS IS BASED ON CONNECTORS MANUFACTURED BY SIMPSON STRONG-TIE IN ACCORDANCE WITH CATALOG "WOOD CONSTRUCTION CONNECTORS" 2017-2018 C-C-2017. SUBSTITUTES SHALL BE SUBMITTED WITH A CURRENT ICC-ES EVALUATION REPORT AND AN ITEMIZED SUBSTITUTION LIST FOR APPROVAL. CONNECTORS SHALL BE INSTALLED IN CONFORMANCE WITH MANUFACTURER'S INSTRUCTIONS.



NAILING NOT SHOWN SHALL BE AS SHOWN IN IBC TABLE 2304.10.1 NAILS SHALL COMPLY WITH ASTM F1667. MINIMUM NAIL DIMENSIONS SHALL BE AS FOLLOWS:

SIZE	DIAMETER	LENGTH
6d	0.113"	2"
8d	0.131"	2 1/2"
10d	0.148"	3"
12d	0.148"	3 1/4"
16d	0.162"	3 1/2"
20d	0.192"	4"

BOLTS AND LAG SCREWS SHALL CONFORM TO ASTM A307.

PRESERVATIVE TREATED WOOD: ALL WOOD MEMBERS EXPOSED TO WEATHER AND SPECIFIED AS "PT" ON THE DRAWINGS SHALL BE PRESERVATIVE-TREATED IN ACCORDANCE WITH AWWA U1. EACH MEMBER SHALL BE IDENTIFIED BY THE QUALITY MARK OF AN INSPECTION AGENCY LISTED BY THE AMERICAN LUMBER STANDARDS TREATED WOOD PROGRAM, AND COMPLYING WITH IBC SECTION 2303.1.9 FASTENERS IN SUCH WOOD MEMBERS SHALL BE HOT DIPPED ZINC COATED GALVANIZED PER ASTM A153, STAINLESS STEEL, SILICON BRONZE OR COPPER.

FILE NAME: WS\Mukiteo\14W121_FerryTermConst\CADD\WSF\ \$FILES\$								SR 525 MUKILTEO FERRY TERMINAL (PHASE 2) FERRY TERMINAL CONSTRUCTION	SX00.11
PRINTED: 6:49:23 AM 9/21/2018	LAST PRINTED BY: Morin				FED.AID PROJ.NO. WA-2017-007-00				
SUBMITTAL DATE: 9/21/2018					REGION NO. STATE 10 WASH		GENERAL STRUCTURAL NOTES	SHEET 1389 OF 1521 SHEETS	
DESIGNED BY: X. LU	9/21/2018				JOB NUMBER 18W121				
ENTERED BY: M. MORIN	9/21/2018				CONTRACT NO. 00*****				
CHECKED BY: C. STEARNS	9/21/2018								
MAR PROJ ENGR: C. TORRES	9/21/2018								
DIR TERM ENGR: N. MCINTOSH									
ASST SECRETARY: A. SCARTON		REVISION	DATE	BY					

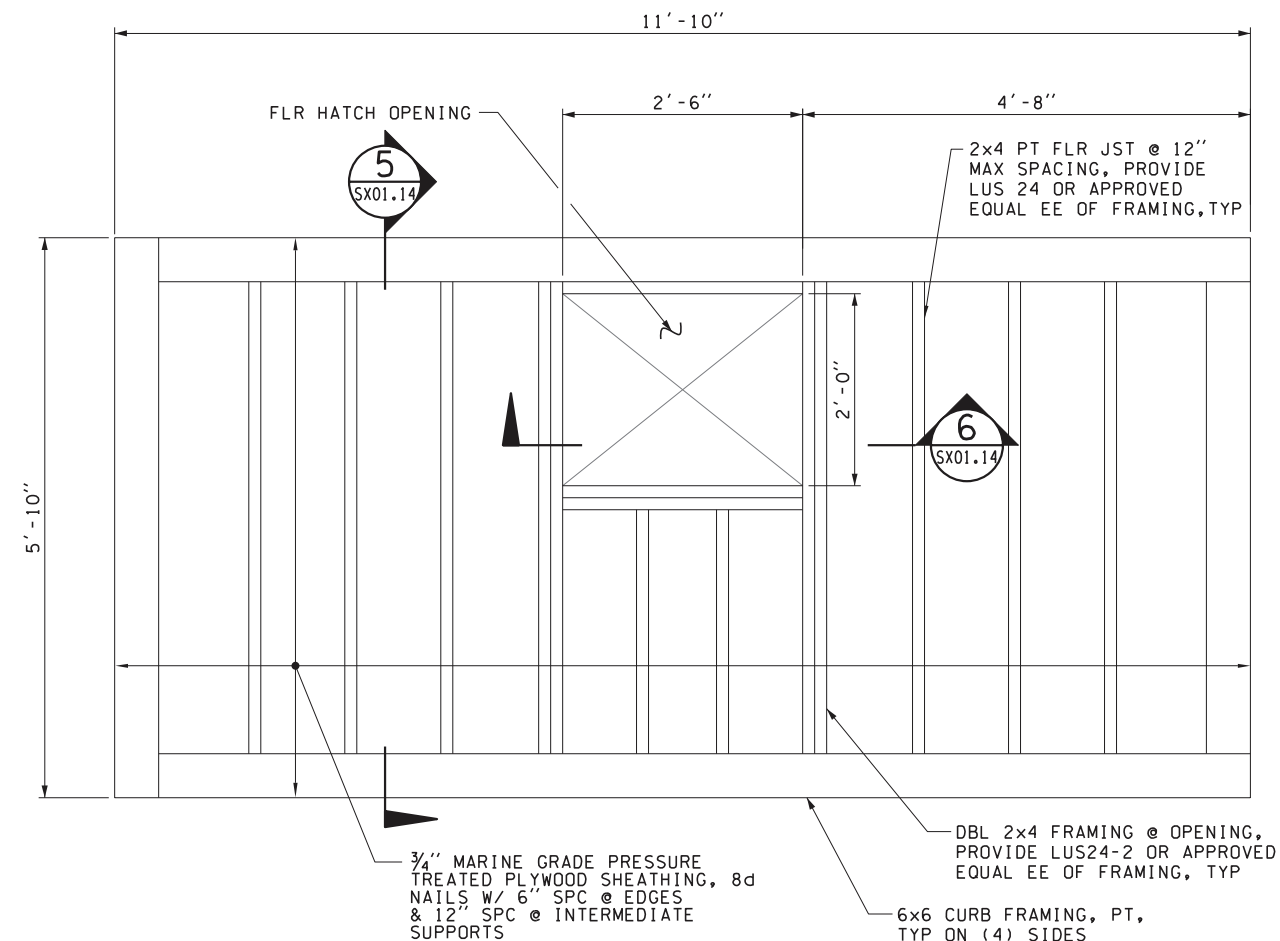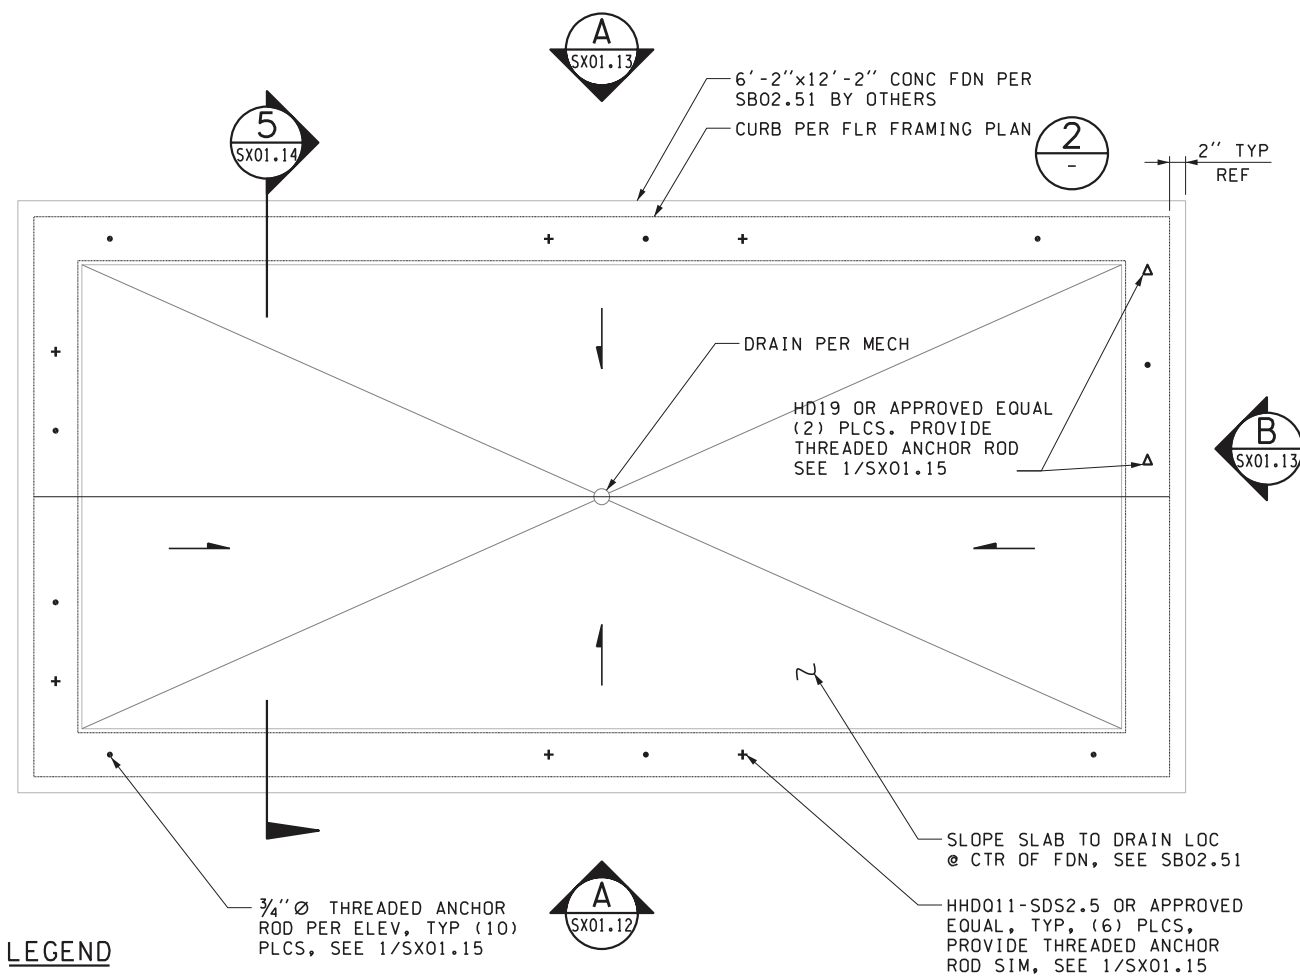

FILE NAME: WSF\Mukilteo\14W121_FerryTermConst\CADD\WSF\ \$FILES\$				
PRINTED: 6:49:25 AM 9/21/2018	LAST PRINTED BY: Morin			FED.AID PROJ.NO. WA-2017-007-00
SUBMITTAL DATE: 9/21/2018				REGION NO. STATE 10 WASH
DESIGNED BY: X. LU	9/21/2018			JOB NUMBER 18W121
ENTERED BY: M. MORIN	9/21/2018			CONTRACT NO. 00****
CHECKED BY: C. STEARNS	9/21/2018			
MAR PROJ ENGR: C. TORRES	9/21/2018			
DIR TERM ENGR: N. MCINTOSH				
ASST SECRETARY: A. SCARTON		REVISION	DATE	BY




SR 525
MUKILTEO FERRY TERMINAL (PHASE 2)
FERRY TERMINAL CONSTRUCTION
FOUNDATION AND FLOOR PLAN


SX01.10
SHEET
1390
OF
1521
SHEETS

LEGEND

- 1. METAL TIES SHALL BE NOT LESS THAN 16 GALVANIZED GAGE IN THICKNESS BY 1½ INCHES IN WIDTH AND SHALL HAVE A YIELD STRESS NOT LESS THAN 33,000 PSI.
- 2. METAL TIES SHALL BE CONTINOUS ALONG THE BLOCKINGS.
- 3. METAL TIES SHALL BE ATTACHED TO BLOCKING IN ACCORDANCE WITH THE MANUFACTURER’S INSTRUCTIONS BUT WITH NOT LESS THAN EIGHT 16d COMMON NAILS ON EACH SIDE OF THE HEADER -JOISTS INTERSECTION.

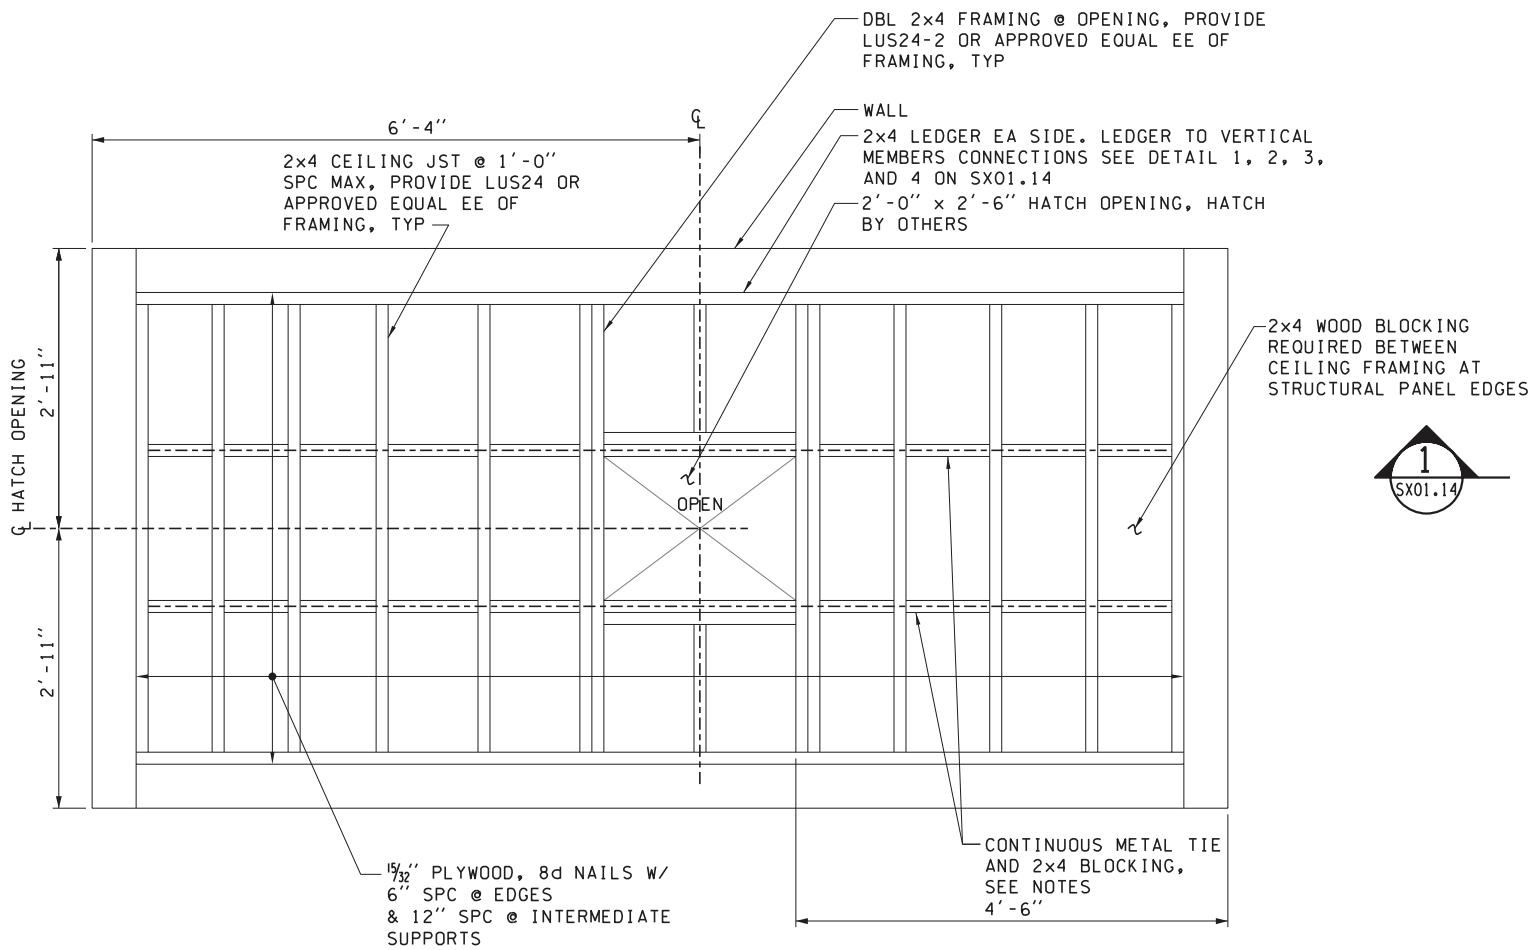


1 CEILING FRAMING PLAN

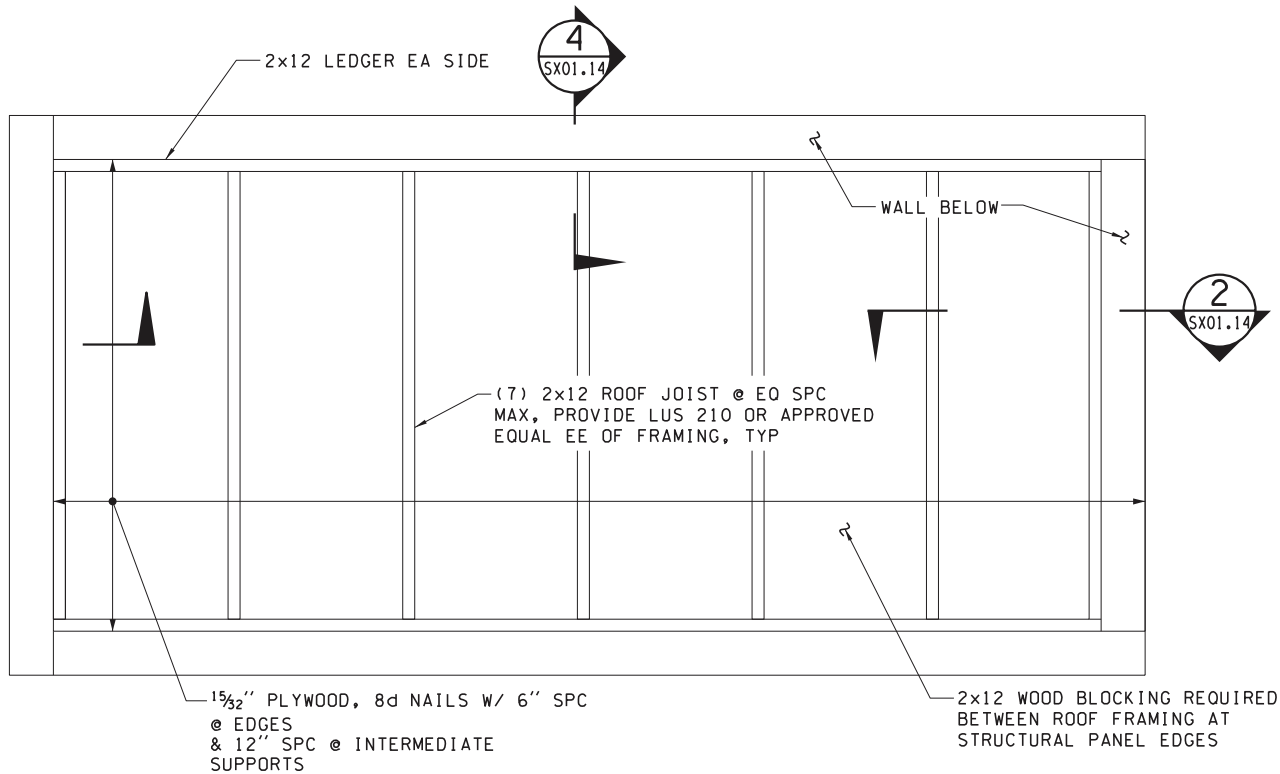


2 ROOF FRAMING PLAN

FILE NAME: WS\Mukilteo\14W121_FerryTermConst\CADD\WSF\ \$FILES\$					
PRINTED: 6:49:28 AM 9/21/2018	LAST PRINTED BY: Morin				FED.AID PROJ.NO.
SUBMITTAL DATE: 9/21/2018					WA-2017-007-00
DESIGNED BY: X. LU	9/21/2018				REGION NO. STATE
ENTERED BY: M. MORIN	9/21/2018				10 WASH
CHECKED BY: C. STEARNS	9/21/2018				JOB NUMBER
MAR PROJ ENGR: C. TORRES	9/21/2018				18W121
DIR TERM ENGR: N. MCINTOSH					CONTRACT NO.
ASST SECRETARY: A. SCARTON		REVISION	DATE	BY	00****

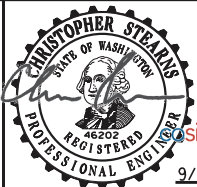

SR 525
MUKILTEO FERRY TERMINAL (PHASE 2)
FERRY TERMINAL CONSTRUCTION
TOLL BOOTH PLANS


SX01.11
SHEET
1391
OF
1521
SHEETS

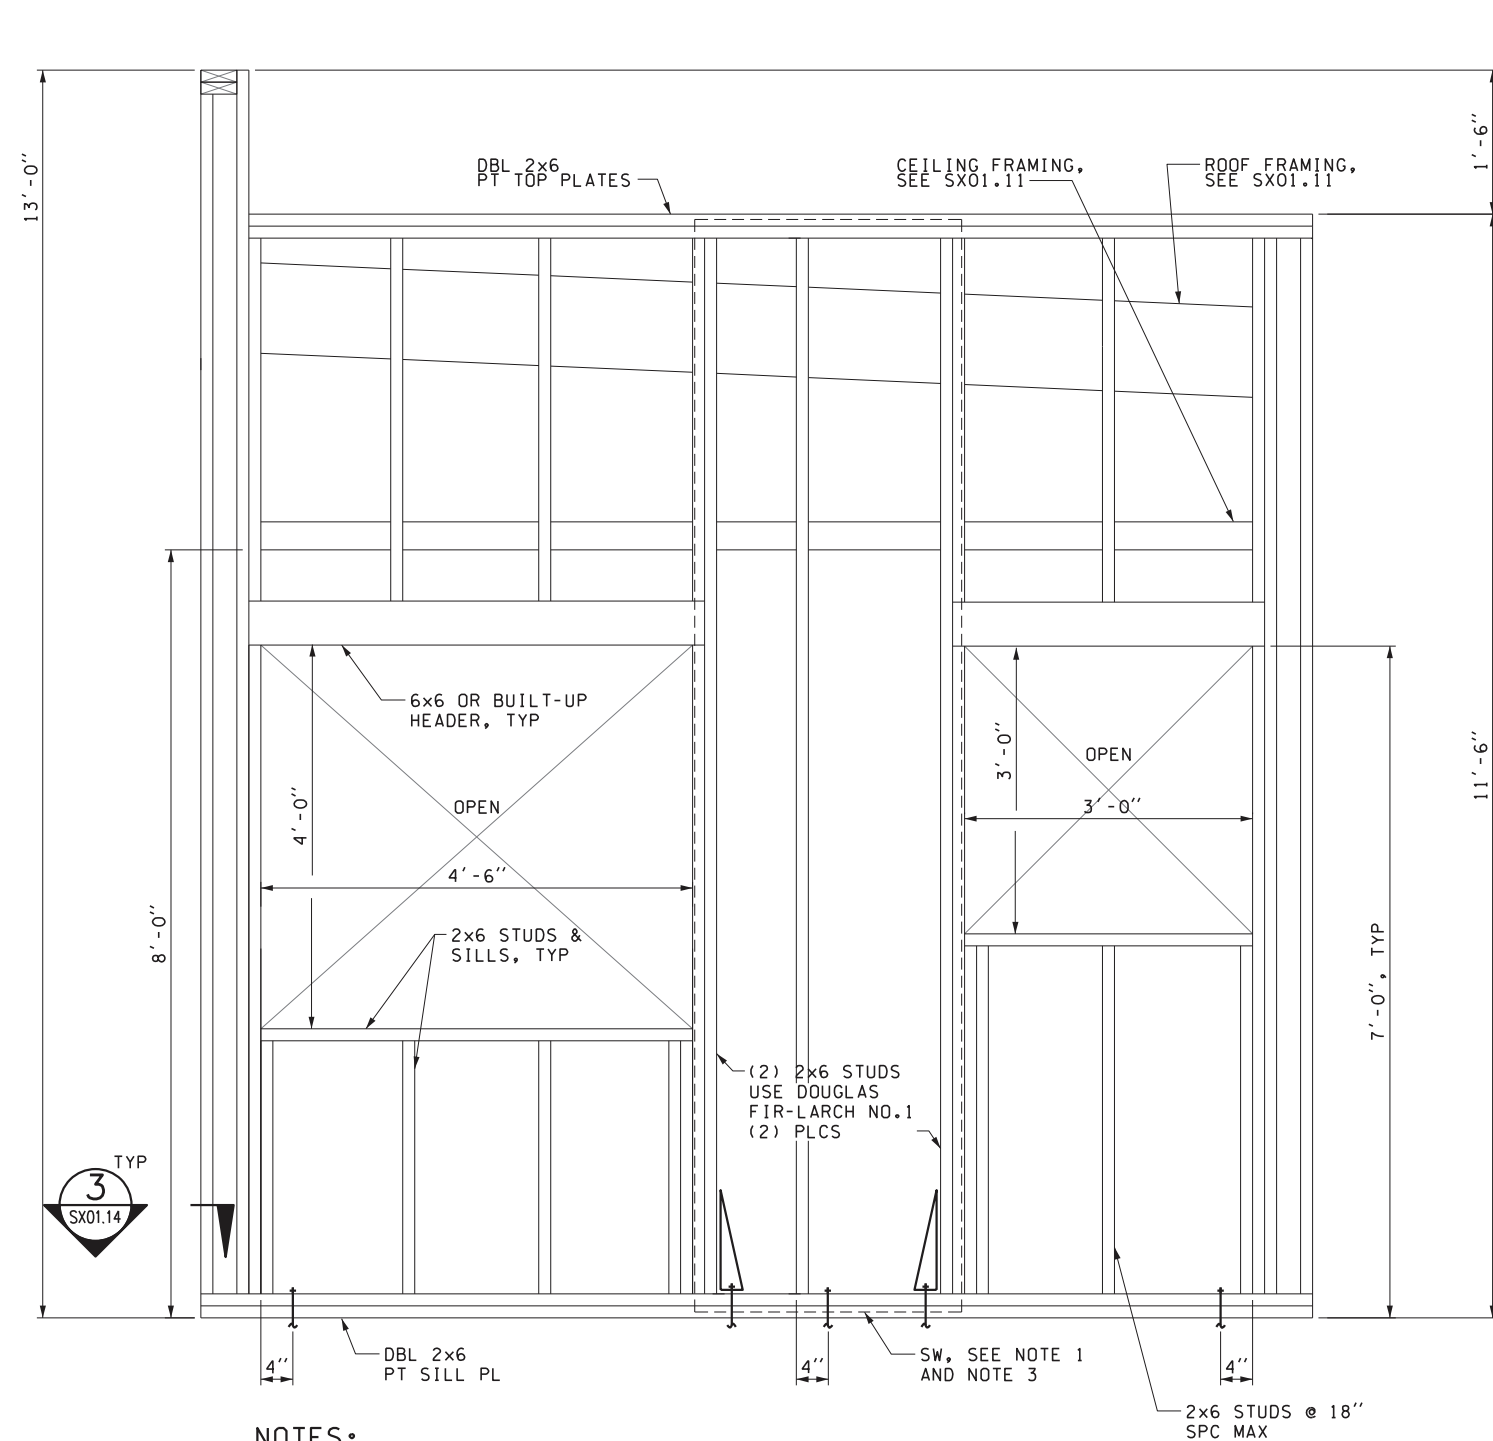

NOTES:

1. SHEAR WALL SHEATHING IS $\frac{1}{2}$ " PLYWOOD, FASTEN WITH 10d NAILS WITH 3" SPACING AT PANEL EDGE AND 12" SPACING AT INTERMEDIATE SUPPORTS.
2. TYPICAL WALL SHEATHING IS $\frac{1}{2}$ " PLYWOOD, FASTEN WITH 10d NAILS WITH 6" SPACING AT PANEL EDGES AND 12" SPACING AT INTERMEDIATE SUPPORTS.
3. 2x WOOD BLOCKING REQUIRED BETWEEN STUDS AT STRUCTURAL PANEL EDGES.

A SERVICE SIDE ELEVATION
SX01.10

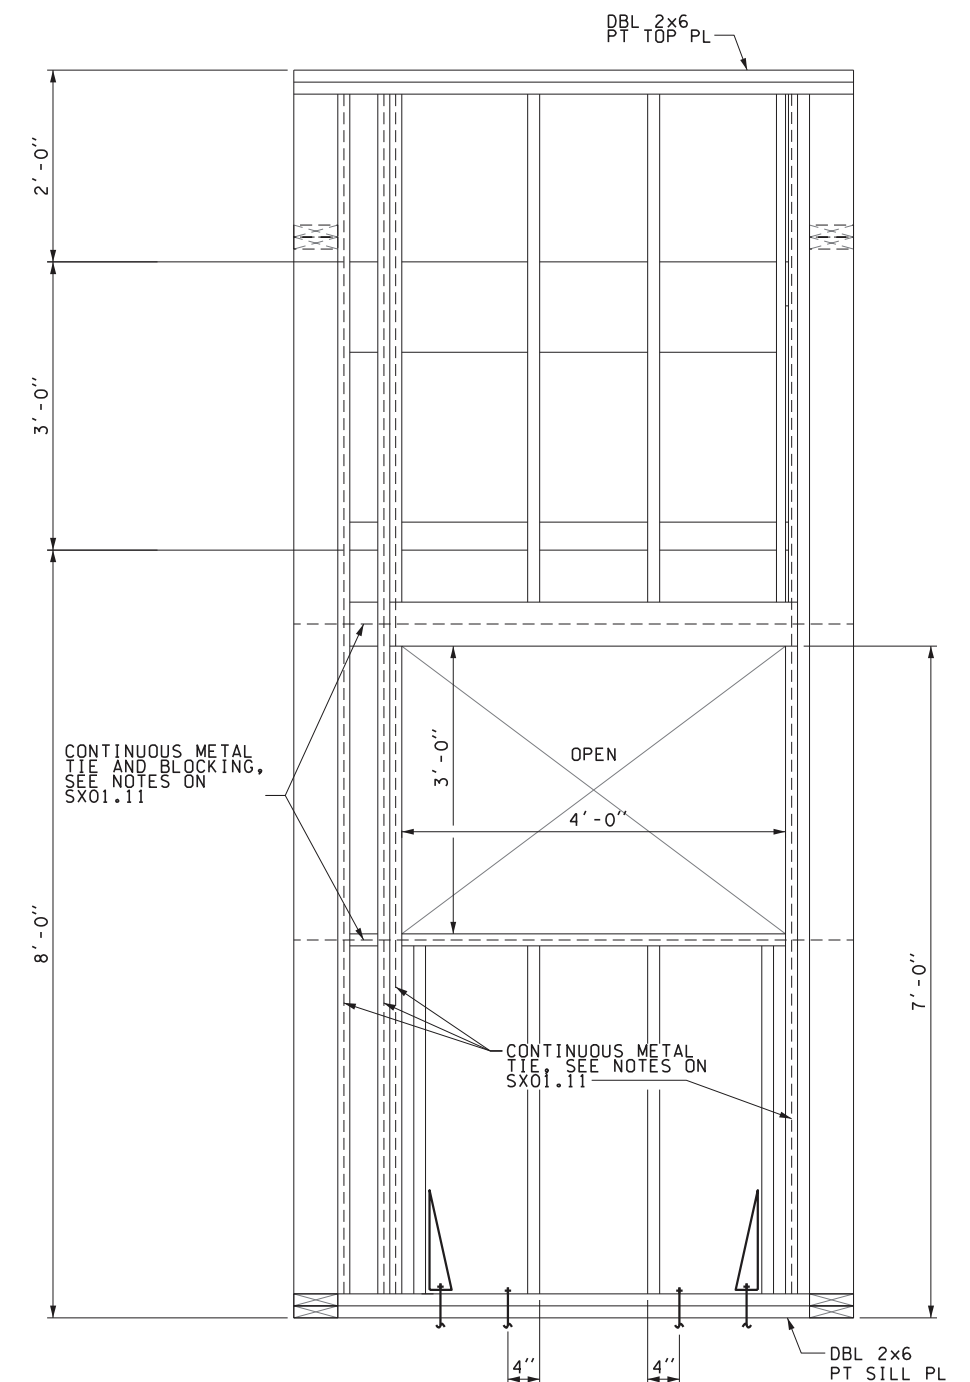

NOTES:

1. SEE A/SX01.12 FOR ADDITIONAL INFORMATION NOT SHOWN.
2. TYPICAL WALL SHEATHING IS $\frac{1}{2}$ " PLYWOOD, FASTEN WITH 10d NAILS WITH 3" SPACING AT PANEL EDGES AND 12" SPACING AT INTERMEDIATE SUPPORTS.
3. 2x WOOD BLOCKING REQUIRED BETWEEN STUDS AT STRUCTURAL PANEL EDGES.


B FRONT ELEVATION
SX01.10

FILE NAME: WSF\Mukilteo\14W121_FerryTermConst\CADD\WSF\ \$FILES\$				
PRINTED: 6:49:31 AM 9/21/2018	LAST PRINTED BY:			FED.AID PROJ.NO.
SUBMITTAL DATE: 9/21/2018	Morin			WA-2017-007-00
DESIGNED BY: X. LU	9/21/2018			REGION NO. STATE
ENTERED BY: M. MORIN	9/21/2018			10 WASH
CHECKED BY: C. STEARNS	9/21/2018			JOB NUMBER
MAR PROJ ENGR: C. TORRES	9/21/2018			18W121
DIR TERM ENGR: N. MCINTOSH				CONTRACT NO.
ASST SECRETARY: A. SCARTON				00****
	REVISION	DATE	BY	



SR 525
MUKILTEO FERRY TERMINAL (PHASE 2)
FERRY TERMINAL CONSTRUCTION
TOLL BOOTH ELEVATIONS I


SX01.12
SHEET
1392
OF
1521
SHEETS

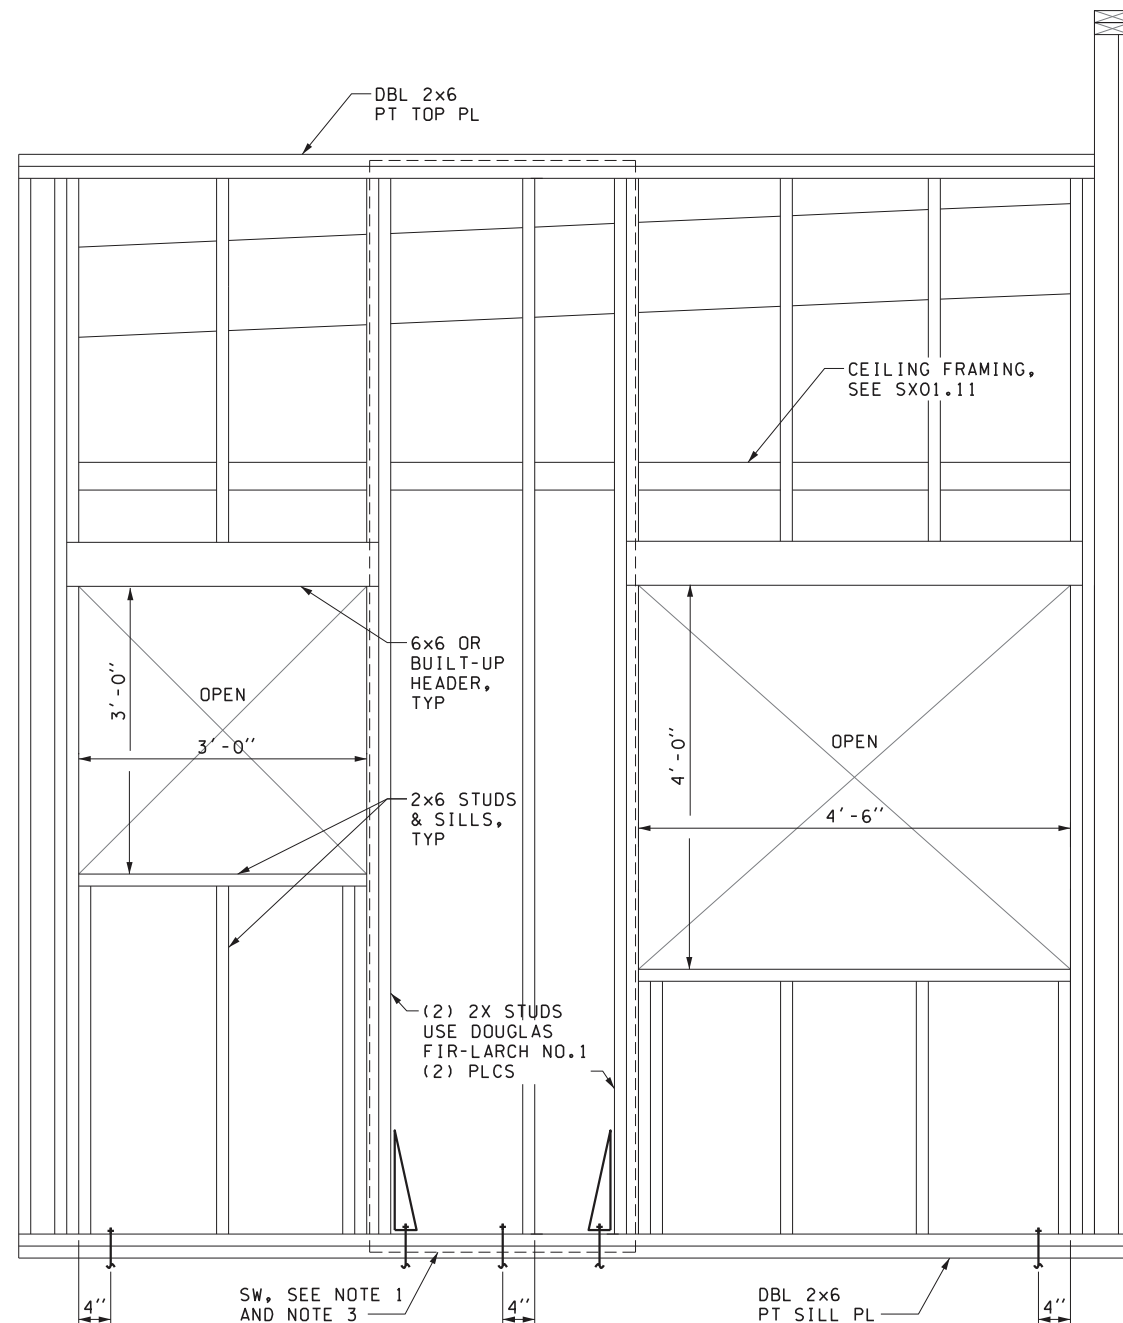

NOTES:

1. SHEAR WALL SHEATHING IS $\frac{1}{32}$ " PLYWOOD, FASTEN WITH 10d NAILS WITH 3" SPACING AT PANEL EDGE AND 12" SPACING AT INTERMEDIATE SUPPORTS.
2. TYPICAL WALL SHEATHING IS $\frac{1}{32}$ " PLYWOOD, FASTEN WITH 10d NAILS WITH 6" SPACING AT PANEL EDGES AND 12" SPACING AT INTERMEDIATE SUPPORTS.
3. 2x WOOD BLOCKING REQUIRED BETWEEN STUDS AT STRUCTURAL PANEL EDGES.

A SIDE ELEVATION
SX01.10

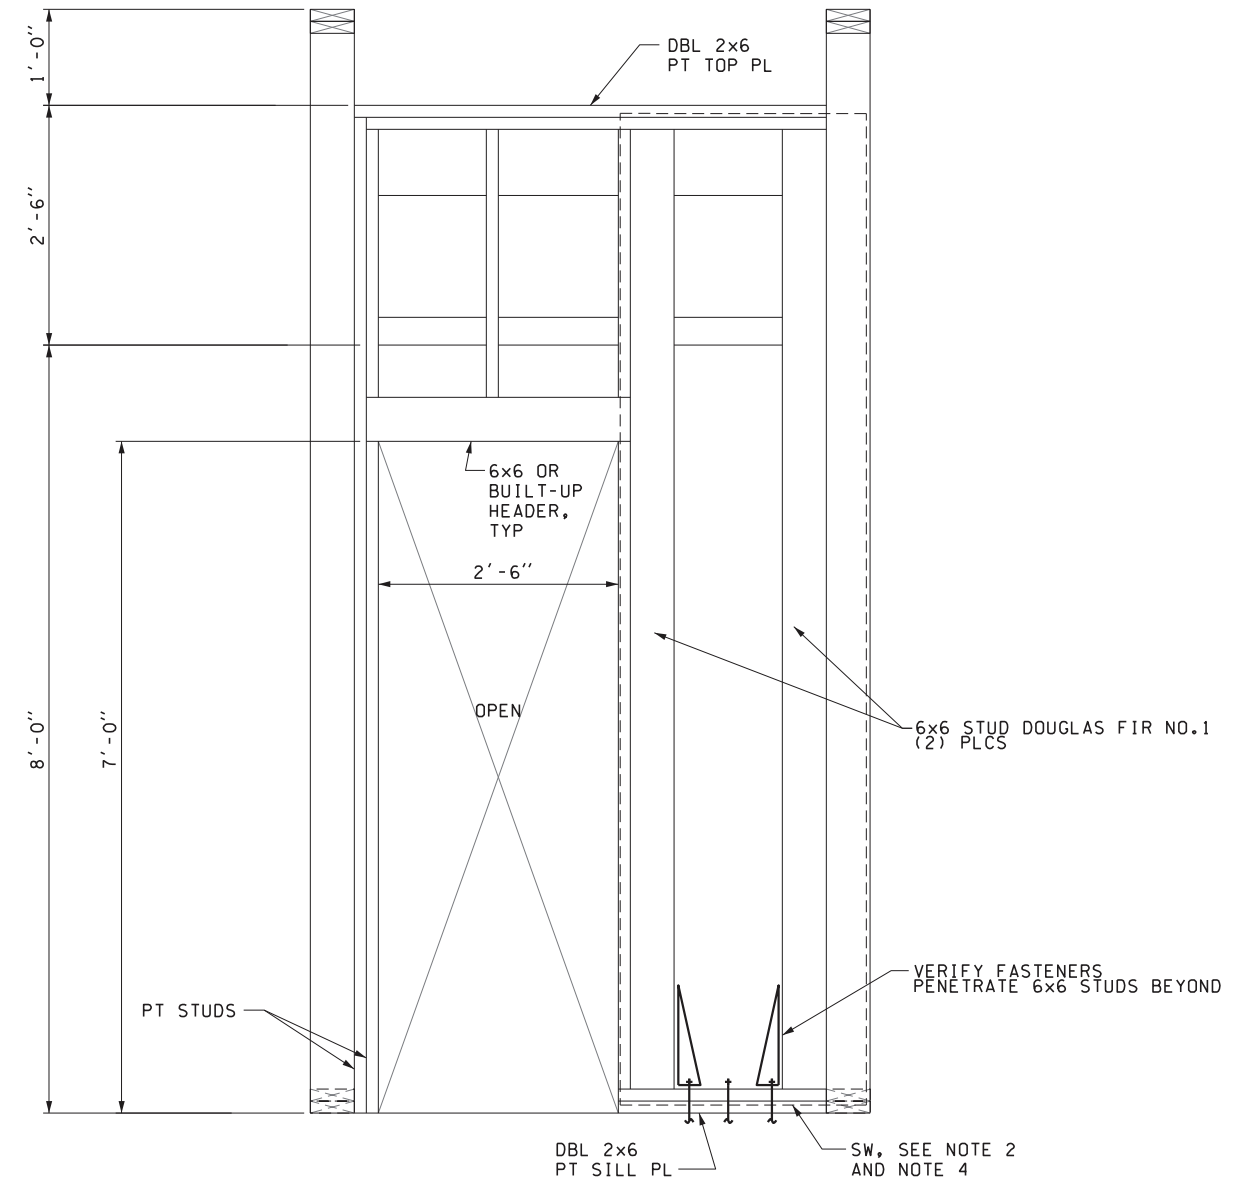

NOTES:

1. SEE A/SX01.13 FOR ADDITIONAL INFORMATION NOT SHOWN.
2. SHEAR WALL SHEATHING IS $\frac{1}{32}$ " PLYWOOD, FASTEN WITH 10d NAILS WITH 3" SPACING AT PANEL EDGE AND 12" SPACING AT INTERMEDIATE SUPPORTS.
3. TYPICAL WALL SHEATHING IS $\frac{1}{32}$ " PLYWOOD, FASTEN WITH 10d NAILS WITH 6" SPACING AT PANEL EDGES AND 12" SPACING AT INTERMEDIATE SUPPORTS.
4. 2x WOOD BLOCKING REQUIRED BETWEEN STUDS AT STRUCTURAL PANEL EDGES.


B REAR ELEVATION
SX01.10

FILE NAME: WSF\Mukiteo\14W121_FerryTermConst\CADD\WSF\ \$FILES\$					
PRINTED: 6:49:34 AM 9/21/2018	LAST PRINTED BY: Morin				FED.AID PROJ.NO. WA-2017-007-00
SUBMITTAL DATE: 9/21/2018					REGION NO. STATE 10 WASH
DESIGNED BY: X. LU	9/21/2018				JOB NUMBER 18W121
ENTERED BY: M. MORIN	9/21/2018				CONTRACT NO. 00****
CHECKED BY: C. STEARNS	9/21/2018				
MAR PROJ ENGR: C. TORRES	9/21/2018				
DIR TERM ENGR: N. MCINTOSH					
ASST SECRETARY: A. SCARTON		REVISION	DATE	BY	




SR 525
MUKILTEO FERRY TERMINAL (PHASE 2)
FERRY TERMINAL CONSTRUCTION
TOLL BOOTH ELEVATIONS II


SX01.13
SHEET
1393
OF
1521
SHEETS

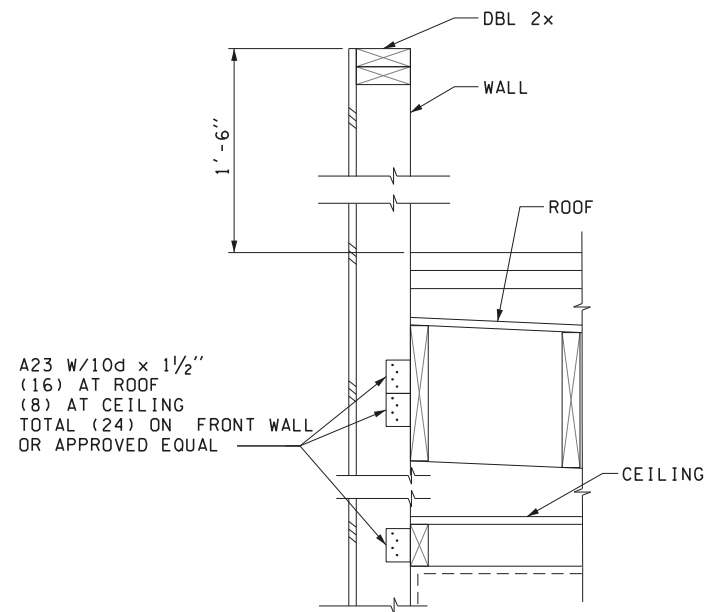


1
DETAIL
ROOF & CEILING TO
FRONT WALL CONN
SX01.11

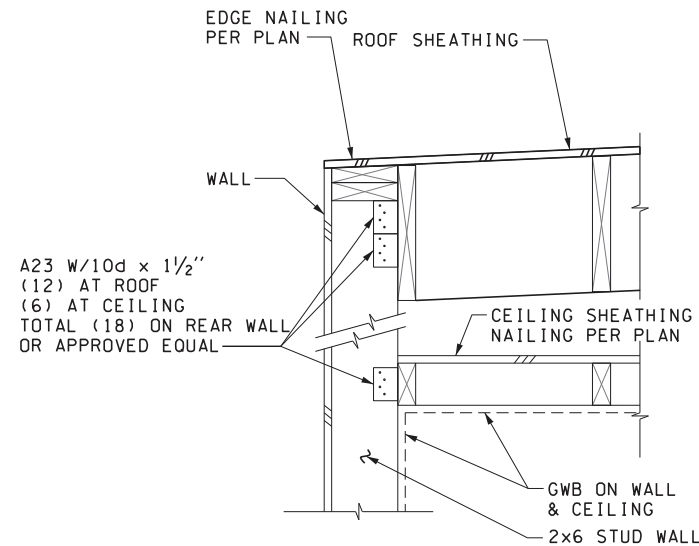


2
DETAIL
ROOF & CEILING TO
REAR WALL CONN
SX01.11

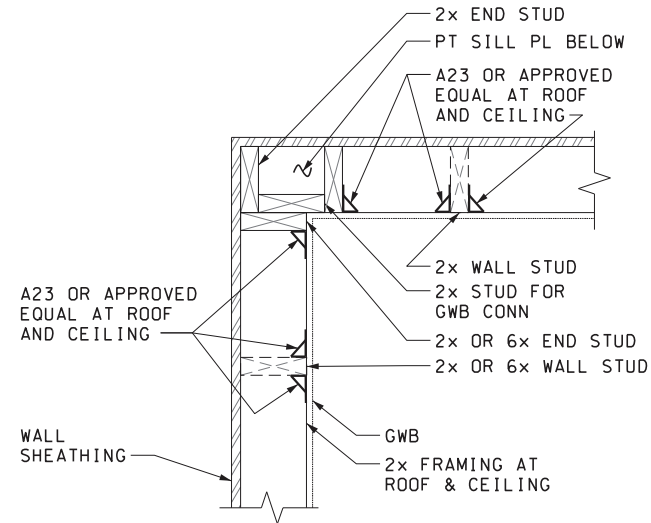


3
DETAIL - TYPICAL
WALL FRAMING AT CORNER
SX01.12

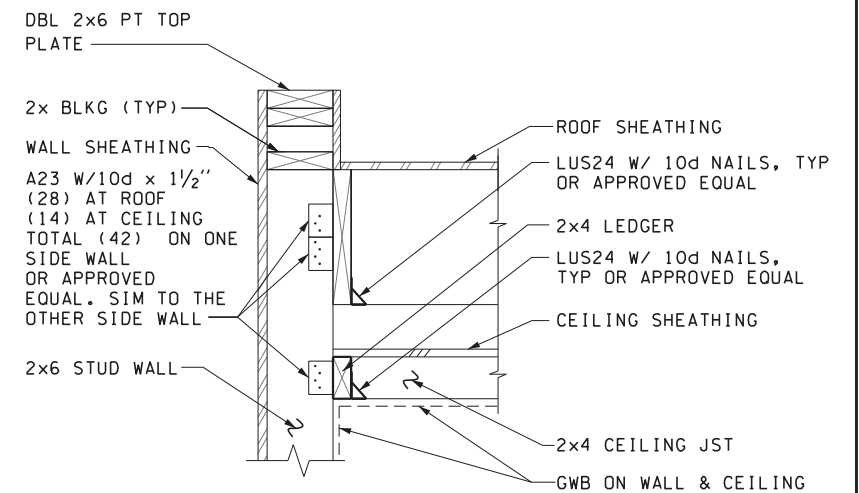

4
DETAIL
ROOF & CEILING TO SIDE WALL
SX01.11

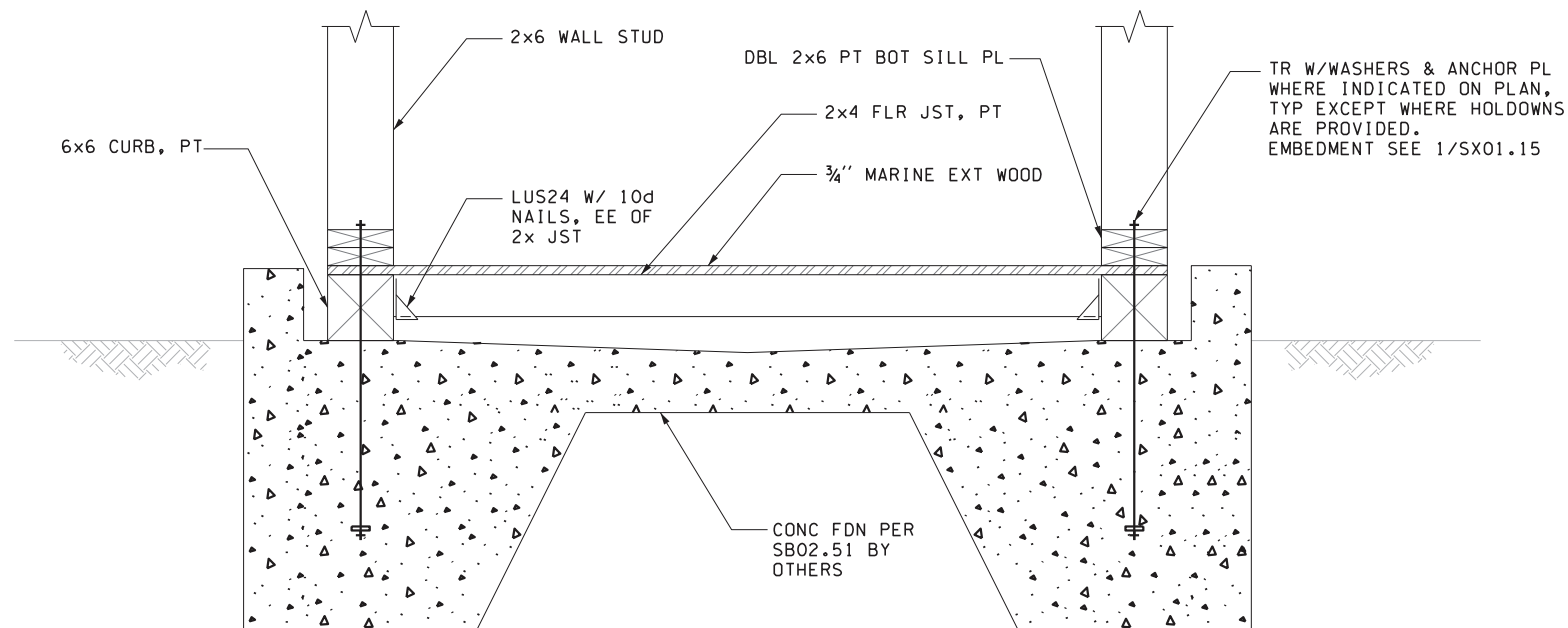

5
SECTION
FOUNDATION AND FLOOR FRAMING
SX01.10

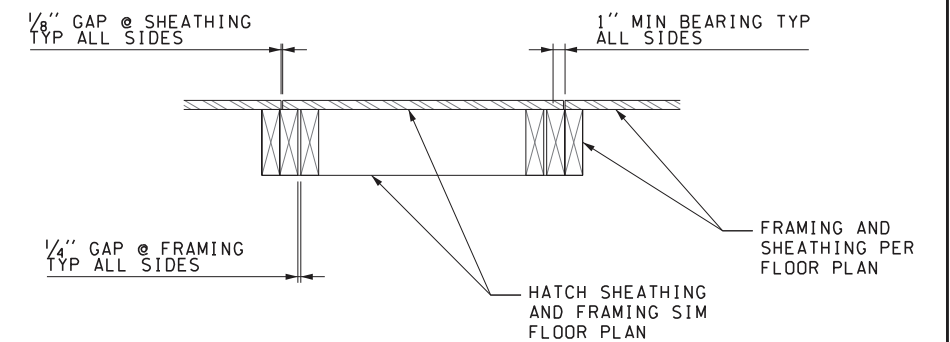

6
FLOOR HATCH
SX01.10

FILE NAME: WS\Mukilteo\14W121_FerryTermConst\CADD\WSF\ \$FILES\$

PRINTED: 6:49:36 AM 9/21/2018

SUBMITTAL DATE: 9/21/2018

DESIGNED BY: X. LU

ENTERED BY: M. MORIN

CHECKED BY: C. STEARNS

MAR PROJ ENGR: C. TORRES

DIR TERM ENGR: N. MCINTOSH

ASST SECRETARY: A. SCARTON

LAST PRINTED BY: Morin

9/21/2018

9/21/2018

REVISION

DATE

BY

FED.AID
PROJ.NO.

WA-2017-007-00

REGION NO. STATE

10 WASH

JOB NUMBER

18W121

CONTRACT NO.

00****



9/21/2018



Washington State
Department of Transportation
WASHINGTON STATE FERRIES

SR 525
MUKILTEO FERRY TERMINAL (PHASE 2)
FERRY TERMINAL CONSTRUCTION

TOLL BOOTH SECTIONS AND DETAILS

SX01.14


SHEET

1394

OF

1521


SHEETS

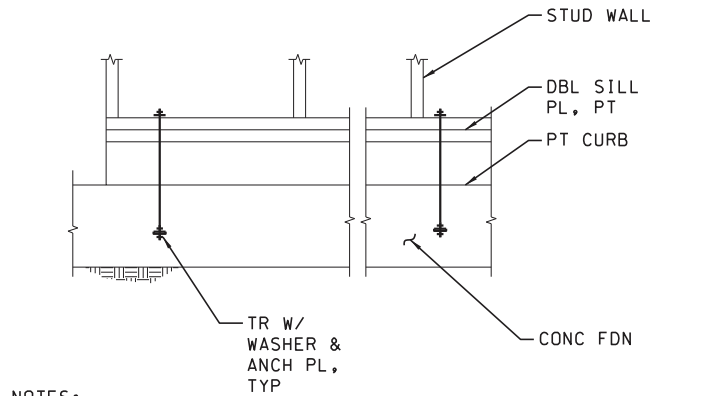


NOTES:

1. 3/4" DIAMETER THREADED ROD WITH 1'-0" EMBEDMENT INTO CONCRETE FOUNDATION. OTHERS WITH 1'-3 1/2" EMBEDMENT INTO CONCRETE FOUNDATION.
2. LOCATE THREADED ROD WITHIN SILL PLATE PER PLAN. PLACE THREADED ROD TO LOCATE WASHER EDGE WITHIN 1/2" OF SILL EDGE ON SHEATHED SIDE OF WALL FRAMING.
3. USE 3"x3"x3/16" SQUARE PLATE WASHER AT TOP AND BOTTOM OF THREADED ROD. PROVIDED NUT EACH SIDE OF BOTTOM PLATE.
4. DO NOT OVERSIZE HOLES DRILLED THROUGH SILL PLATE. HOLES SHALL BE A MINIMUM 1/32" TO A MAXIMUM OF 1/16" LARGER THAN THE BOLT DIAMETER.
5. SEE PLANS AND ELEVATIONS FOR SILL PLATE THICKNESS AND FASTENING REQUIRED AT SHEAR WALLS.

1 SILL PLATE ANCHORAGE TO CONCRETE
NTS

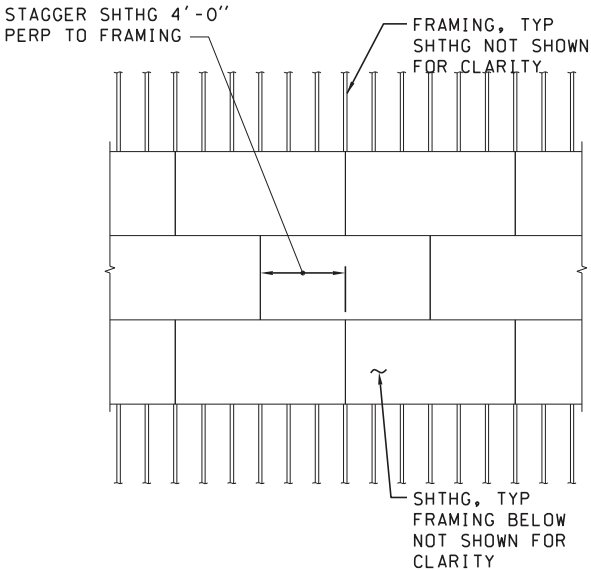


2 TYPICAL SHEATHING PLAN
NTS

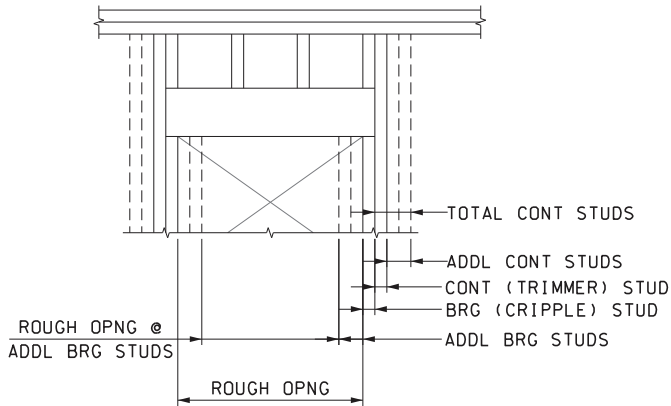

NOTES:

1. FASTEN EACH CONTINUOUS STUD TO INNER STUD WITH STANDARD COMMON 0.131" DIAMETER x 3" FACE NAILS AT 16" ON CENTER FOR FULL HEIGHT OF EACH STUD (NOT SHOWN FOR CLARITY).
2. SEE ELEVATIONS FOR STUD REQUIREMENTS

3 WINDOW/DOOR HEADER AT INTERIOR/EXTERIOR WALLS
NTS

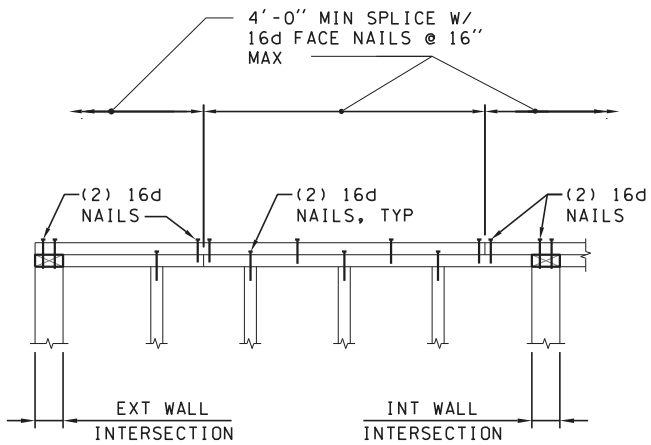

NOTE:

1. STANDARD COMMON "16d NAIL" IS 0.162" DIA x 3 1/2".

4 MINIMUM TOP PLATE SPLICE
NTS

FILE NAME: WSF\Mukilteo\14W121_FerryTermConst\CADD\WSF\ \$FILES\$					
PRINTED: 6:49:39 AM 9/21/2018	LAST PRINTED BY: Morin				FED.AID PROJ.NO. WA-2017-007-00
SUBMITTAL DATE: 9/21/2018					REGION NO. STATE 10 WASH
DESIGNED BY: X. LU	9/21/2018				JOB NUMBER 18W121
ENTERED BY: M. MORIN	9/21/2018				CONTRACT NO. 00****
CHECKED BY: C. STEARNS	9/21/2018				
MAR PROJ ENGR: C. TORRES	9/21/2018				
DIR TERM ENGR: N. MCINTOSH					
ASST SECRETARY: A. SCARTON		REVISION	DATE	BY	



9/21/2018



SR 525
MUKILTEO FERRY TERMINAL (PHASE 2)
FERRY TERMINAL CONSTRUCTION

TYPICAL DETAILS

SX01.15
SHEET
1395
OF
1521
SHEETS

ELECTRICAL PLAN SYMBOLS

EQUIPMENT AND DEVICES

\$	SINGLE POLE TOGGLE SWITCH
\$&	SWITCH WITH SUBSCRIPT &. & CAN BE: 3 = 3-WAY TOGGLE SWITCH 4 = 4-WAY TOGGLE SWITCH b = TOGGLE SWITCH, SWITCH LEG B D = INTEGRAL 0-10V DIMMING DIAL O = INTEGRAL OCCUPANCY SENSOR V = INTEGRAL VACANCY SENSOR
▼	TELEPHONE OUTLET
▽	DATA OUTLET
JB or Q	JUNCTION BOX (J-BOX)
⌚	MOTOR CONNECTION
□	PANEL OR CABINET
⊙	ENGINE GENERATOR
⊕	RECEPTACLE, 480V, 3 PHASE
⦿	GROUND ROD
⦿ _T	GROUND TEST WELL
—	GROUND CABLE, 2'-6" (MIN) BELOW GRADE
30□	NONFUSED DISCONNECT SWITCH. SIZE INDICATED, 3 POLE UNLESS OTHERWISE INDICATED.
60 40□	FUSED DISCONNECT SWITCH. SIZE INDICATED, (60 = SWITCH RATING, 40 = FUSE RATING) 3 POLE UNLESS OTHERWISE INDICATED
60□	
1⊞	COMBINATION MAGNETIC STARTER, NEMA SIZE INDICATED, 3 POLE UNLESS OTHERWISE INDICATED.
Ⓣ	THERMOSTAT
Ⓣ	TRANSFORMER (PLAN)
Ⓜ	VAULT, UTILITY VAULT
□	HORN
⊞	TYPE 1 JUNCTION BOX PER STANDARD PLANS
⊞	TYPE 2 JUNCTION BOX PER STANDARD PLANS
⊞	TYPE 8 JUNCTION BOX PER STANDARD PLANS
⬡ xx-xxx xxx	= EQUIP TAG = EQUIP RATING (HP OR WATT)
⊕	FIRST RESPONDER RADIO ENHANCEMENT ANTENNA
Ⓢ	PAGING SPEAKER
Ⓢ	WALL MOUNTED PAGING SPEAKER

LIGHTING

⬡ A 310	LIGHT FIXTURE DESIGNATION, SEE LIGHT FIXTURE SCHEDULE FOR TYPE "A" 310 WATTS
⬡ E	SURFACE LIGHT FIXTURE ON EMERGENCY POWER TO SCALE ON DRAWINGS
⬡ E	
□	SURFACE MOUNT LIGHT FIXTURE TO SCALE ON DRAWINGS
□	
⬡	RECESSED LIGHT FIXTURE ON EMERGENCY POWER TO SCALE ON DRAWINGS
⬡	
□	RECESSED OR LINEAR LIGHT FIXTURE TO SCALE ON DRAWINGS
□	
□	NL = NIGHT LIGHT. UNSWITCHED LIGHT OR ONE OR MORE UNSWITCHED LAMPS AS NOTED.
□ NL	
□ 7b	7b = FED BY CIRCUIT #7, SWITCH LEG B.
—○—	STRIPLIGHT LUMINAIRE
—	LINEAR WALL MOUNTED LUMINAIRE
⊙	LIGHT FIXTURE
⊙	LIGHT FIXTURE ON EMERGENCY POWER
Ⓛ	EMERGENCY LIGHTING UNIT
→⊙	EXIT SIGN, SURFACE OR CEILING MOUNTED, SINGLE FACE WITH DIRECTIONAL ARROWS AS INDICATED.
→⊙	EXIT SIGN, SURFACE OR CEILING MOUNTED, DOUBLE FACE WITH DIRECTIONAL ARROWS AS INDICATED.
→⊙	EXIT SIGN, WALL MOUNTED, SINGLE FACE WITH DIRECTIONAL ARROWS AS INDICATED.
Ⓛ	WALL MOUNTED LIGHT FIXTURE
○	LIGHT POLE
⊙	WALL WASHER
⊙	IN-GRADE UPLIGHT LUMINAIRE


RECEPTACLES

⊕	DUPLEX RECEPTACLE
⊕ GFI	DUPLEX RECEPTACLE, GFI=GROUND FAULT INTERRUPTER PROTECTED
⊕ WP	DUPLEX RECEPTACLE, WP = WEATHERPROOF COVER
⊕	SIMPLEX RECEPTACLE
⊕	4-PLEX RECEPTACLE
⊕ _{SP}	SURGE PROTECTIVE DUPLEX RECEPTACLE
⊕ _{WR}	WEATHER RESISTANT DUPLEX RECEPTACLE

RACEWAY/CIRCUIT DESIGNATIONS

⬡ P###	CONDUIT/CIRCUIT TAG, SEE CONDUIT AND CABLE SCHEDULE
↩ L1/3,5	CONDUIT: TICS DENOTE QUANTITY OF WIRES, LONG = NEUTRAL, CROSS TIC = GROUND, MIN 3/4"C, #12 AWG UNLESS NOTED OTHERWISE, ARROW = HOMERUN, L1/3,5 = PANEL/CIRCUIT
⊕	LB, LR, OR LL TYPE CONDUIT BODY TURNING AWAY FROM VIEWER
⊕	LB, LR, OR LL TYPE CONDUIT BODY TURNING TOWARDS VIEWER
⊕	LB, LR, OR LL TYPE CONDUIT BODY
⊕	T TYPE CONDUIT BODY
—	FLEXIBLE CORD OR CABLE
— HT —	HEAT TRACE
— OP —	OVERHEAD POWER
— BP —	BURIED POWER
— OC —	OVERHEAD COMMUNICATIONS OR CONTROL
— BC —	BURIED COMMUNICATIONS OR CONTROL
—	HEAVY SOLID LINES INDICATE NEW CONDUIT MATERIAL AND EQUIPMENT THAT IS EXPOSED
—	SCREENED SOLID LINES INDICATE EXISTING CONDUIT MATERIAL AND EQUIPMENT THAT IS EXPOSED
----	HEAVY DASHED LINES INDICATE NEW CONDUIT MATERIAL AND EQUIPMENT THAT IS HIDDEN FROM VIEW
----	SCREENED DASHED LINES INDICATE EXISTING CONDUIT MATERIAL AND EQUIPMENT THAT IS HIDDEN FROM VIEW

WIRE LABELING

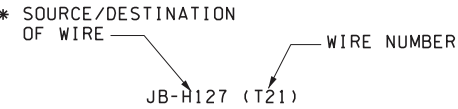

* THE SOURCE OR DESTINATION OF THE WIRE IS THE
NEXT DEVICE THAT PROVIDES A TERMINAL FOR
THIS WIRE.

FILE NAME: WSF\Mukilteo\14W121_FerryTermConst\CADD\WSF\ 14w121ex01_00 Legend1.dwg								SR 525 MUKILTEO FERRY TERMINAL (PHASE 2) FERRY TERMINAL CONSTRUCTION	EX01.00
PRINTED: 12:45:48 PM 12/13/2017	LAST PRINTED BY: Morin								
SUBMITTAL DATE: 12/22/2017						FED.AID PROJ.NO. WA-2017-007-00		ELECTRICAL SYMBOLS	SHEET 1396 OF 1521 SHEETS
DESIGNED BY: S. HOLLOWAY	12/22/2017					REGION NO. STATE 10 WASH			
ENTERED BY: M. MORIN	12/22/2017					JOB NUMBER 18W121			
CHECKED BY: E. RAJAH	12/22/2017					CONTRACT NO. 00*****			
MAR PROJ ENGR: C. TORRES	12/22/2017								
DIR TERM ENGR: N. MCINTOSH									
ASST SECRETARY: A. SCARTON		REVISION	DATE	BY					

GENERAL NOTES:

1. DIMENSIONS & SIZES SHOWN ARE IN FEET AND INCHES UNLESS OTHERWISE NOTED.
2. THE CONTRACTOR SHALL FIELD VERIFY THE EXISTING CONDITIONS AS DEPICTED ON THESE PLANS INCLUDING QUANTITIES, LOCATIONS, RATINGS, AND FUNCTION OF EXISTING EQUIPMENT, CONDUIT, AND WIRE. THE CONTRACTOR SHALL FIELD VERIFY ALL DIMENSIONS AND SHALL ASSUME FULL RESPONSIBILITY FOR MEASURED QUANTITIES.
3. THE CONTRACTOR SHALL COORDINATE POWER, CONTROL, AND COMMUNICATIONS SYSTEMS SHUTDOWN WITH THE ENGINEER TO MINIMIZE DISRUPTION OF NORMAL FACILITY OPERATION.
4. CONDUIT AND WIRE NOTED FOR DEMOLITION SHALL BE REMOVED FROM THEIR POINT OF BEGINNING TO WHERE THEY TERMINATE. THE CONTRACTOR SHALL NOTIFY THE ENGINEER OF ALL ABANDONED WIRING ENCOUNTERED.
5. EQUIPMENT DIMENSIONS AND CONFIGURATION SHOWN ARE APPROXIMATE. ACTUAL SIZE AND LAYOUT SHALL BE PER THE ENGINEER APPROVED CONTRACTOR'S SHOP DRAWINGS.
6. CONTRACTOR IS RESPONSIBLE FOR ARRANGING AND PROVIDING TEMPORARY POWER AND LIGHTING FOR WORK AREAS.
7. PROVIDE CONDUIT TAGS FOR ALL EXISTING AND NEW CONDUITS INDICATED ON THE PLANS.
8. SIZE JUNCTION BOXES PER NEC 314.28 UNLESS SHOWN OTHERWISE ON PLANS.

CABLE & CONDUIT ABBREVIATIONS

2"C,10#12,2#12SP,#12G(C10)	2" CONDUIT, TYPE PER SPECIAL PROVISIONS; TEN #12 CONDUCTORS PLUS TWO SPARE #12'S AND A #12 GROUND CONDUCTOR, INSULATION TYPE PER SPECIAL PROVISIONS; "C10" CONDUIT LABEL.
1½"C(C100)	1½" CONDUIT, TYPE PER SPECIAL PROVISIONS; SEE ONE-LINES OR PLANS FOR ENCLOSED CABLE AND WIRE INFORMATION; "C100" CONDUIT LABEL.
¾"EC (F10)	¾" EMPTY CONDUIT WITH PULL STRING, TYPE PER SPECIAL PROVISIONS; "F10" CONDUIT LABEL.
1"LFMC(H10)	1" LIQUIDTIGHT FLEXIBLE METAL CONDUIT, SEE ONE-LINES OR PLANS FOR ENCLOSED CABLE AND WIRE INFORMATION; "H10" CONDUIT LABEL. (LFMC, EC = EMPTY LIQUIDTIGHT FLEXIBLE METAL CONDUIT)
24/C#12(10)	MULTICONDUCTOR CABLE. TWENTY-FOUR CONDUCTORS, SIZE #12; "10" CABLE LABEL.

ABBREVIATIONS

A, AMP(S)	AMPERE(S)	HF	HEADFRAME
AB	ALLEN-BRADLEY	HGR	HANGER
AF	AMPERE FRAME	HH	HANDHOLE
AFF	ABOVE FINISH FLOOR	HID	HIGH INTENSITY DISCHARGE
AG	AUXILIARY GUTTER	HOA	HAND-OFF-AUTO
AIC	AMPERES INTERRUPTING CAPACITY	HP	HORSEPOWER
ALRM	ALARM	HPS	HIGH PRESSURE SODIUM
ANN, ANNC	ANNUNCIATOR	HPU	HYDRAULIC POWER UNIT
APPROX	APPROXIMATELY	HT	HEAT TRACE
AT	AMPERE TRIP	HYD	HYDRAULIC
ATS	AUTOMATIC TRANSFER SWITCH	HPU	HYDRAULIC POWER UNIT
AUX	AUXILIARY		
AWG	AMERICAN WIRE GAUGE		
		IC	INTERRUPTING CAPACITY
		ID	INSIDE DIAMETER
		IMC	INTERMEDIATE METAL CONDUIT
		IR	INFRARED
BKR	BREAKER	J, JB, J-BOX	JUNCTION BOX
BOM	BILL OF MATERIALS	JS	JOYSTICK
C	CONDUIT, CONDUCTOR	Kcmil, KCM	THOUSAND CIRCULAR MILLS
CAB	CABINET	KV	KILOVOLT
CAT	CATALOG	KVA	KILOVOLT AMPERE
CB	CIRCUIT BREAKER	KVAR	KILOVAR(S)
CL	CENTERLINE	KW	KILOWATT
CDF	CONTROLLED DENSITY FILL		
CKT	CIRCUIT	L	LEFT
CO	CONDUIT ONLY	LC	LIGHTING CONTACTOR
COMB	COMBINATION	LCC	LINE CONTROL CABINET
COMM	COMMUNICATION	LFC	LIQUIDTIGHT FLEXIBLE CONDUIT
CP	CONTROL PANEL	LFMC	LIQUIDTIGHT FLEXIBLE METAL CONDUIT
CPT	CONTROL POWER TRANSFORMER	LOC'D	LOCATED
CPU	CENTRAL PROCESSING UNIT	LT	LIGHT
CR	CONTROL RELAY	LS	LIMIT SWITCH
CS	CONTROL STATION		
CT	CURRENT TRANSFORMER	M	MAGNETIC CONTACTOR COILS, METERS, MOTOR
CTRL	CONTROL	MCB	MAIN CIRCUIT BREAKER
CU	COPPER	MCC	MOTOR CONTROL CENTER
		MCR	MASTER CONTROL RELAY
		MH	METAL HALIDE; MANHOLE
		MISC	MISCELLANEOUS
		MLO	MAIN LUGS ONLY
		MM, mm	MILLIMETER(S)
		MPZ	MINI POWER ZONE
		MS	MOTOR STARTER
		MTR	MOTOR
		MTS	MANUAL TRANSFER SWITCH
		N	NORTH
		NCHO	NORMALLY CLOSED HELD OPEN
		NEC	NATIONAL ELECTRICAL CODE
		NEUT	NEUTRAL
		NOHC	NORMALLY OPEN HELD CLOSED
		NP	NAMEPLATE
		NTS	NOT TO SCALE
		OC	ON CENTER
		OD	OUTSIDE DIAMETER
		OP	OVERHEAD POWER
		P	POLE
		PA	PUBLIC ADDRESS
		PB	PUSHBUTTON
		PE, PC	PHOTOELECTRIC SENSOR (PHOTOCELL)
		PH	PHASE
		PL OR P	PLATE
		PLC	PROGRAMMABLE LOGIC CONTROLLER
		PNL	PANEL
DC	DIRECT CURRENT		
DIA	DIAMETER		
DIST	DISTRIBUTION		
DN	DOWN		
DS	DISCONNECT SWITCH		
DWG	DRAWING		
E	EAST		
EC	EMPTY CONDUIT		
EG	ENGINE GENERATOR		
EGC	EQUIPMENT GROUND CONDUCTOR		
ELEC, ELECT	ELECTRICAL		
EMT	ELECTRICAL METALLIC TUBING		
ENC	ENCLOSED		
EQUIP	EQUIPMENT		
EXIST	EXISTING		
EWC	ELECTRIC WATER COOLER		
FC, FLEX	FLEXIBLE CONDUIT		
FDR	FEEDER		
FLC	FLUORESCENT, COMPACT		
FT	FEET		
FS	FLOAT SWITCH		
FU, F	FUSE		
FVR	FULL VOLTAGE REVERSING		
FVNR	FULL VOLTAGE NON-REVERSING		
FWD	FORWARD		
G, GND	GROUND		
GA	GAUGE		
GALV	GALVANIZED		
GEN	GENERATOR		
GFI	GROUND FAULT INTERRUPTER		
GL	GREEN LIGHT		
GWB	GYPSUM WALL BOARD		

SR 525

MUKILTEO FERRY TERMINAL (PHASE 2)
FERRY TERMINAL CONSTRUCTION

ELECTRICAL ABBREVIATIONS
AND NOTES

EX01.01

SHEET

1397

OF

1521

SHEETS

FILE NAME: WSF\Mukiteo\14W121_FerryTermConst\CADD\WSF\ 14w121ex01_01 Abbreviations.dlv					
PRINTED: 12:45:50 PM 12/13/2017	LAST PRINTED BY: Morin				FED.AID PROJ.NO.
SUBMITTAL DATE: 12/22/2017					WA-2017-007-00
DESIGNED BY: S. HOLLOWAY	12/22/2017				REGION NO. STATE
ENTERED BY: M. MORIN	12/22/2017				10 WASH
CHECKED BY: E. RAJAH	12/22/2017				JOB NUMBER
MAR PROJ ENGR: C. TORRES	12/22/2017				18W121
DIR TERM ENGR: N. MCINTOSH					CONTRACT NO.
ASST SECRETARY: A. SCARTON		REVISION	DATE	BY	00*****




cosign

12/13/2017



Washington State
Department of Transportation
WASHINGTON STATE FERRIES

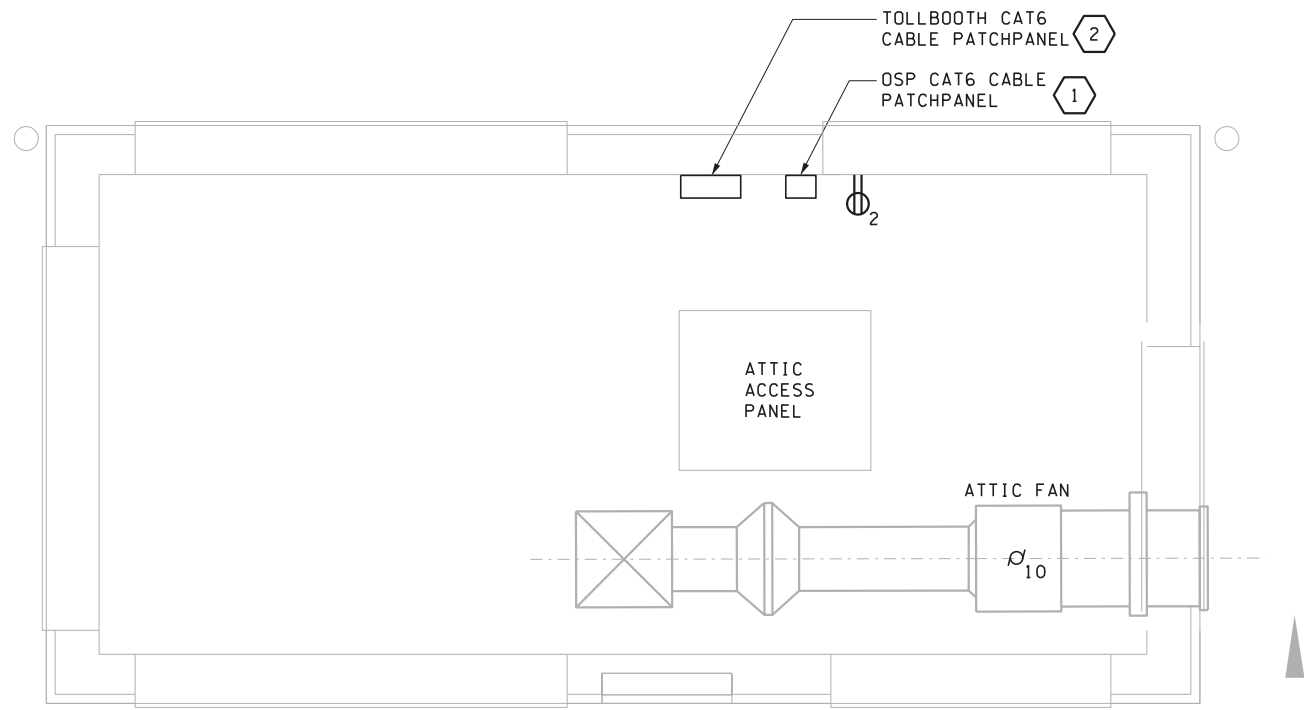

NOTES:


- 1. ALL INDOOR CONDUIT SHALL BE EMT OR FLEXIBLE METAL CONDUIT AND SHALL BE CONCEALED, UNLESS IN ATTIC OR APPROVED OTHERWISE BY THE ENGINEER.
- 2. DATA OUTLETS SHALL BE 4-PORT UNLESS OTHERWISE INDICATED. PROVIDE (4) CAT6 CABLES IN 1" CONDUIT FROM EACH 4-PORT OUTLET TO PATCHPANEL IN ATTIC.
- 3. EQUIPMENT AND DEVICE CIRCUIT NUMBERS ARE SHOWN. PROVIDE CABLE AND CONDUIT TO COMPLETE CIRCUITS AND HOMERUNS AS REQUIRED. INSTALL #12 AWG IN 3/4" CONDUIT UNLESS OTHERWISE INDICATED ON THE PANELBOARD SCHEDULE FOR THE CIRCUIT NUMBER SHOWN.

CONSTRUCTION NOTES:


- 1 PROVIDE 12-PORT CAT6 WALL MOUNTED PATCH PANEL FOR OUTSIDE PLANT (OSP) CABLE. PROVIDE 2" CONDUIT FROM ATTIC TO CONTROL SECTION OF SERVICE PULL BOX.
- 2 PROVIDE 24-PORT CAT6 WALL MOUNTED PATCH PANEL FOR TOLLBOOTH CAT6 CABLES. PROVIDE (24) 3' CAT6 PATCH CABLES.

TOLLBOOTH #1 ATTIC ELECTRICAL PLAN


(SIMILAR FOR TOLLBOOTH #2 AND #3)

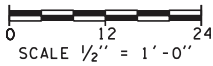

FILE NAME: WSF\Mukilteo\14W121_FerryTermConst\CADD\WSF\ \$FILES\$												SR 525		EX02.02
PRINTED: 6:47:52 AM 9/21/2018		LAST PRINTED BY: Morin										MUKILTEO FERRY TERMINAL (PHASE 2)		
SUBMITTAL DATE: 9/21/2018												FERRY TERMINAL CONSTRUCTION		
DESIGNED BY: S. HOLLOWAY		9/21/2018				WA-2017-007-00						TOLLBOOTH ATTIC ELECTRICAL PLAN		SHEET
ENTERED BY: M. MORIN		9/21/2018				REGION NO. STATE								1400
CHECKED BY: E. RAJAH		9/21/2018				10 WASH								OF
MAR PROJ ENGR: C. TORRES		9/21/2018				JOB NUMBER								1521
DIR TERM ENGR: N. MCINTOSH						18W121								SHEETS
ASST SECRETARY: A. SCARTON				REVISION		DATE		BY						
						FED.AID PROJ.NO.								
						WA-2017-007-00								
						REGION NO. STATE								
						10 WASH								
						JOB NUMBER								
						18W121								
						CONTRACT NO.								
						00*****								

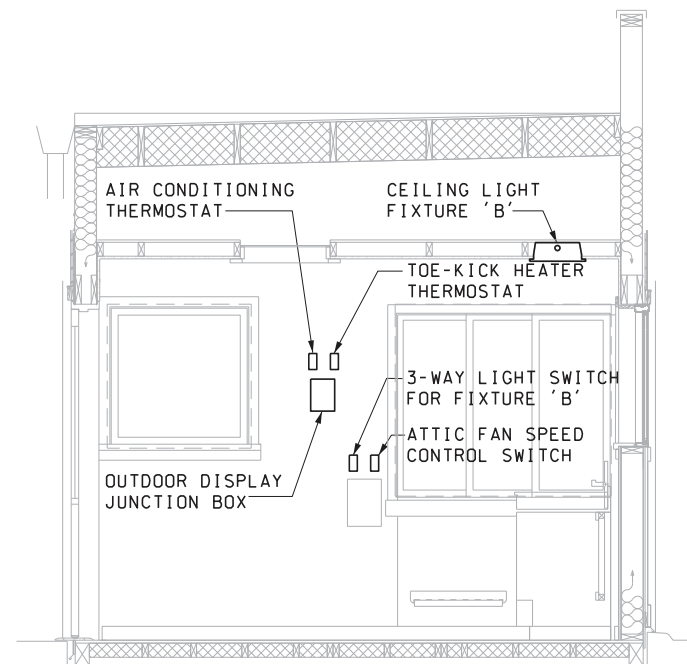


A SECTION
EX02.00
SCALE 1/4" = 1'-0"

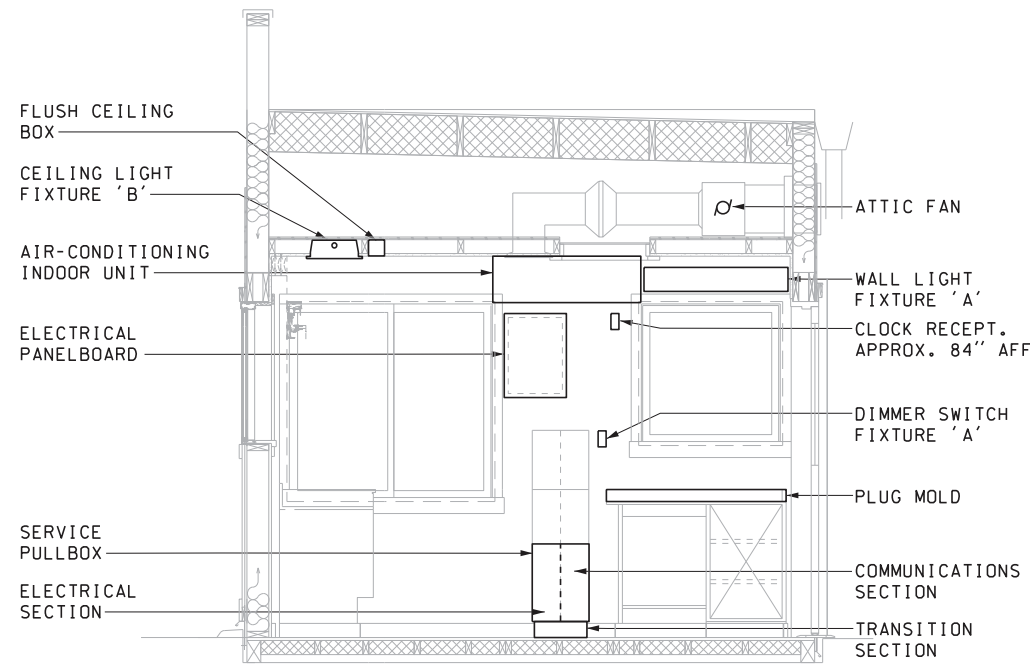

B SECTION
EX02.00
SCALE 1/4" = 1'-0"

CONSTRUCTION NOTES:

- 1 PROVIDE (2) 1" CONDUITS FROM THE DATA JUNCTION BOX TO THE ATTIC.

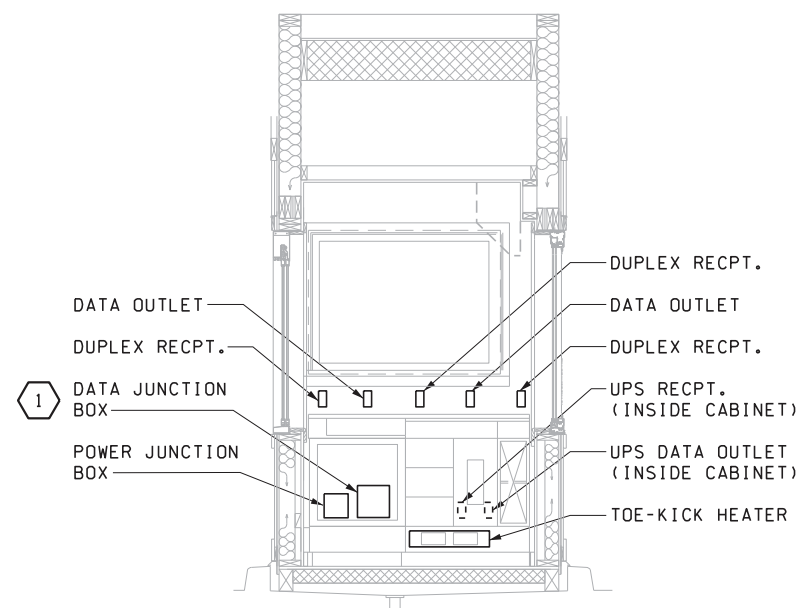

C SECTION
EX02.00
SCALE 1/4" = 1'-0"

FILE NAME: WSF\Mukilteo\14W121_FerryTermConst\CADD\WSF\ \$FILES\$

PRINTED: 6:48:02 AM 9/21/2018

SUBMITTAL DATE: 9/21/2018

DESIGNED BY: S. HOLLOWAY

ENTERED BY: M. MORIN

CHECKED BY: E. RAJAH

MAR PROJ ENGR: C. TORRES

DIR TERM ENGR: N. MCINTOSH

ASST SECRETARY: A. SCARTON

LAST PRINTED BY: Morin

9/21/2018

9/21/2018

REVISION

DATE

BY

FED.AID
PROJ.NO.

WA-2017-007-00

REGION NO. STATE


10 WASH

JOB NUMBER

18W121

CONTRACT NO.

00****

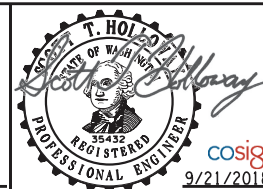

cosign
9/21/2018



Washington State
Department of Transportation
WASHINGTON STATE FERRIES

SR 525
MUKILTEO FERRY TERMINAL (PHASE 2)
FERRY TERMINAL CONSTRUCTION

TOLLBOOTH ELEVATIONS

EX02.03

SHEET

1401

OF

1521

SHEETS

PANEL 2PX2													
MOUNTING: RECESSED			MAIN RATING: 60A MCB			LOCATION: TOLLBOOTH 1							
NEMA RATING: 1			MAIN CABLES: #4										
VOLTAGE: 208/120V, 3PH, 4W			SOURCE: 2PX1			AIC RATINGS: 10,000							
CKT	BREAKER	WIRE SIZE	DESCRIPTION	AMPERES			CKT	BREAKER	WIRE SIZE	DESCRIPTION	AMPERES		
				A	B	C					A	B	C
1	20A/2P	#12	HEATER	6.3	-	-	2	20A/1P	#12	RECEPTACLES CEILING AND ATTIC	1	-	-
3	-	#12	-	-	6.3	-	4	20A/1P	#12	CLOCK	-	1	-
5	20A/1P	#12	LIGHTS - OUTDOOR	-	-	1	6	20A/2P	#12	AIR CONDITIONING UNIT	-	-	6.3
7	20A/1P	#12	LIGHTS - INDOOR	1	-	-	8	-	-	-	6.3	-	-
9	20A/1P	#12	RECEPTACLES FRONT COUNTERTOP	-	4	-	10	20A/1P	#12	ATTIC FAN	-	1.7	-
11	30A/1P	#10	UPS RECEPTACLE	-	-	9.6	12	20A/1P	#12	OUDOOR ELECTRONIC MESSAGE DISPLAY	-	-	7
13	20A/1P	#12	PLUGMOLD	2.5	-	-	14	20A/1P	#12	HEATER EFS CABINET	3.3	-	-
15	20A/1P	#12	PLUGMOLD	-	2.5	-	16	20A/1P	-	SPARE	-	0	-
17	20A/1P	-	SPARE	-	-	0	18	20A/1P	-	SPARE	-	-	0
19	20A/1P	-	SPARE	0	-	-	20	20A/1P	-	SPARE	0	-	-
21	20A/1P	-	SPARE	-	0	-	22	20A/1P	-	SPARE	-	0	-
23	20A/1P	-	SPARE	-	-	0	24	20A/1P	-	SPARE	-	-	0
TOTAL				10	13	11	TOTAL				11	3	13

NOTES:	
1.	
2.	
3.	
4.	
5.	

TOTAL AMPERES	
BUS A	20
BUS B	16
BUS C	24

MAXIMUM KVA
9

SUB-FEED BREAKER	DESCRIPTION	AMPERES		
		A	B	C
-	-	0	0	0

PANEL 2PX3													
MOUNTING: RECESSED			MAIN RATING: 60A MCB			LOCATION: TOLLBOOTH 2							
NEMA RATING: 1			MAIN CABLES: #4										
VOLTAGE: 208/120V, 3PH, 4W			SOURCE: 2PX1			AIC RATINGS: 10,000							
CKT	BREAKER	WIRE SIZE	DESCRIPTION	AMPERES			CKT	BREAKER	WIRE SIZE	DESCRIPTION	AMPERES		
				A	B	C					A	B	C
1	20A/2P	#12	HEATER	6.3	-	-	2	20A/1P	#12	RECEPTACLES CEILING AND ATTIC	1	-	-
3	-	#12	-	-	6.3	-	4	20A/1P	#12	CLOCK	-	1	-
5	20A/1P	#12	LIGHTS - OUTDOOR	-	-	1	6	20A/2P	#12	AIR CONDITIONING UNIT	-	-	6.3
7	20A/1P	#12	LIGHTS - INDOOR	1	-	-	8	-	-	-	6.3	-	-
9	20A/1P	#12	RECEPTACLES FRONT COUNTERTOP	-	4	-	10	20A/1P	#12	FAN	-	1.7	-
11	30A/1P	#10	UPS RECEPTACLE	-	-	9.6	12	20A/1P	#12	OUDOOR ELECTRONIC MESSAGE DISPLAY	-	-	7
13	20A/1P	#12	PLUGMOLD	2.5	-	-	14	20A/1P	#12	HEATER EFS CABINET	3.3	-	-
15	20A/1P	#12	PLUGMOLD	-	2.5	-	16	20A/1P	-	SPARE	-	0	-
17	20A/1P	-	SPARE	-	-	0	18	20A/1P	-	SPARE	-	-	0
19	20A/1P	-	SPARE	0	-	-	20	20A/1P	-	SPARE	0	-	-
21	20A/1P	-	SPARE	-	0	-	22	20A/1P	-	SPARE	-	0	-
23	20A/1P	-	SPARE	-	-	0	24	20A/1P	-	SPARE	-	-	0
TOTAL				10	13	11	TOTAL				11	3	13

NOTES:	
1.	
2.	
3.	
4.	
5.	

TOTAL AMPERES	
BUS A	20
BUS B	16
BUS C	24

MAXIMUM KVA
9

SUB-FEED BREAKER	DESCRIPTION	AMPERES		
		A	B	C
-	-	0	0	0

FILE NAME: WSF\Mukilteo\14W121_FerryTermConst\CADD\WSF\ \$FILES\$									
PRINTED: 6:48:07 AM 9/21/2018		LAST PRINTED BY: Morin							
SUBMITTAL DATE: 9/21/2018								FED.AID PROJ.NO.	
DESIGNED BY: S. HOLLOWAY		9/21/2018						WA-2017-007-00	
ENTERED BY: M. MORIN		9/21/2018						REGION NO. STATE	
CHECKED BY: E. RAJAH		9/21/2018						10 WASH	
MAR PROJ ENGR: C. TORRES		9/21/2018						JOB NUMBER	
DIR TERM ENGR: N. MCINTOSH								18W121	
ASST SECRETARY: A. SCARTON								CONTRACT NO.	
								00****	
		REVISION		DATE		BY			



SR 525
MUKILTEO FERRY TERMINAL (PHASE 2)
FERRY TERMINAL CONSTRUCTION

TOLLBOOTH
PANELBOARD SCHEDULES

PANEL 2PX4													
MOUNTING:		RECESSED		MAIN RATING: 60A MCB				LOCATION: TOLLBOOTH 3					
NEMA RATING:		1		MAIN CABLES: #4									
VOLTAGE:		208/120V, 3PH, 4W		SOURCE: 2PX1				AIC RATINGS: 10,000					
CKT	BREAKER	WIRE SIZE	DESCRIPTION	AMPERES			CKT	BREAKER	WIRE SIZE	DESCRIPTION	AMPERES		
				A	B	C					A	B	C
1	20A/2P	#12	HEATER	6.3	-	-	2	20A/1P	#12	RECEPTACLES CEILING AND ATTIC	1	-	-
3	-	#12	-	-	6.3	-	4	20A/1P	#12	CLOCK	-	1	-
5	20A/1P	#12	LIGHTS - OUTDOOR	-	-	1	6	20A/2P	#12	AIR CONDITIONING UNIT	-	-	6.3
7	20A/1P	#12	LIGHTS - INDOOR	1	-	-	8	-	-	-	6.3	-	-
9	20A/1P	#12	RECEPTACLES FRONT COUNTERTOP	-	4	-	10	20A/1P	#12	ATTIC FAN	-	1.7	-
11	30A/1P	#10	UPS RECEPTACLE	-	-	9.6	12	20A/1P	#12	OUDOOR ELECTRONIC MESSAGE DISPLAY	-	-	7
13	20A/1P	#12	PLUGMOLD	2.5	-	-	14	20A/1P	#12	HEATER EFS CABINET	3.3	-	-
15	20A/1P	#12	PLUGMOLD	-	2.5	-	16	20A/1P	-	SPARE	-	0	-
17	20A/1P	-	SPARE	-	-	0	18	20A/1P	-	SPARE	-	-	0
19	20A/1P	-	SPARE	0	-	-	20	20A/1P	-	SPARE	0	-	-
21	20A/1P	-	SPARE	-	0	-	22	20A/1P	-	SPARE	-	0	-
23	20A/1P	-	SPARE	-	-	0	24	20A/1P	-	SPARE	-	-	0
TOTAL				10	13	11	TOTAL				11	3	13


NOTES:	
1.	
2.	
3.	
4.	
5.	

TOTAL AMPERES	
BUS A	20
BUS B	16
BUS C	24

MAXIMUM KVA
9

SUB-FEED BREAKER	DESCRIPTION	AMPERES		
		A	B	C
-	-	0	0	0

FILE NAME: WSF\Mukilteo\14W121_FerryTermConst\CADD\WSF\ \$FILES\$					
PRINTED: 6:48:16 AM 9/21/2018	LAST PRINTED BY:				FED.AID PROJ.NO.
SUBMITTAL DATE: 9/21/2018	Morin				WA-2017-007-00
DESIGNED BY: S. HOLLOWAY	9/21/2018				REGION NO. STATE
ENTERED BY: M. MORIN	9/21/2018				10 WASH
CHECKED BY: E. RAJAH	9/21/2018				JOB NUMBER
MAR PROJ ENGR: C. TORRES	9/21/2018				18W121
DIR TERM ENGR: N. MCINTOSH					CONTRACT NO.
ASST SECRETARY: A. SCARTON		REVISION	DATE	BY	00****

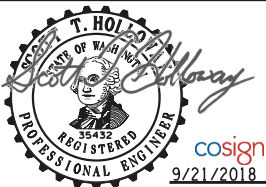


SR 525 MUKILTEO FERRY TERMINAL (PHASE 2) FERRY TERMINAL CONSTRUCTION	
TOLLBOOTH PANELBOARD SCHEDULES	


EX04.01
SHEET 1404 OF 1521 SHEETS

CONSTRUCTION NOTES:

1 DIFFUSER SHALL BE FLUSH MOUNTED WITH BEVEL EDGES AND A LOUVER PATTERN THAT DIRECTS AIR FLOW IN 2 DIRECTIONS 90°FROM EACH OTHER. MOUNT DIFFUSER TO DIRECT AIR TO THE BACK AND FAR SIDE OF TOLL BOOTH.

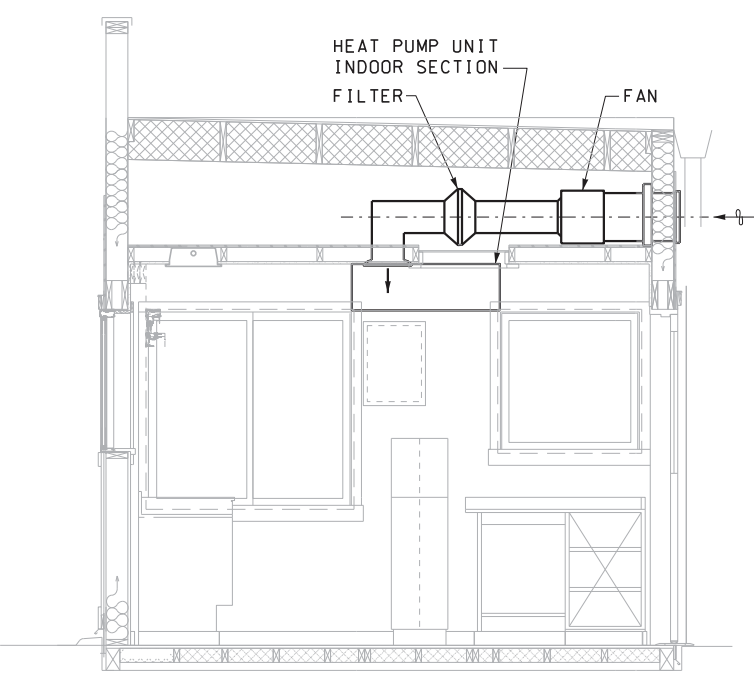

1 SECTION

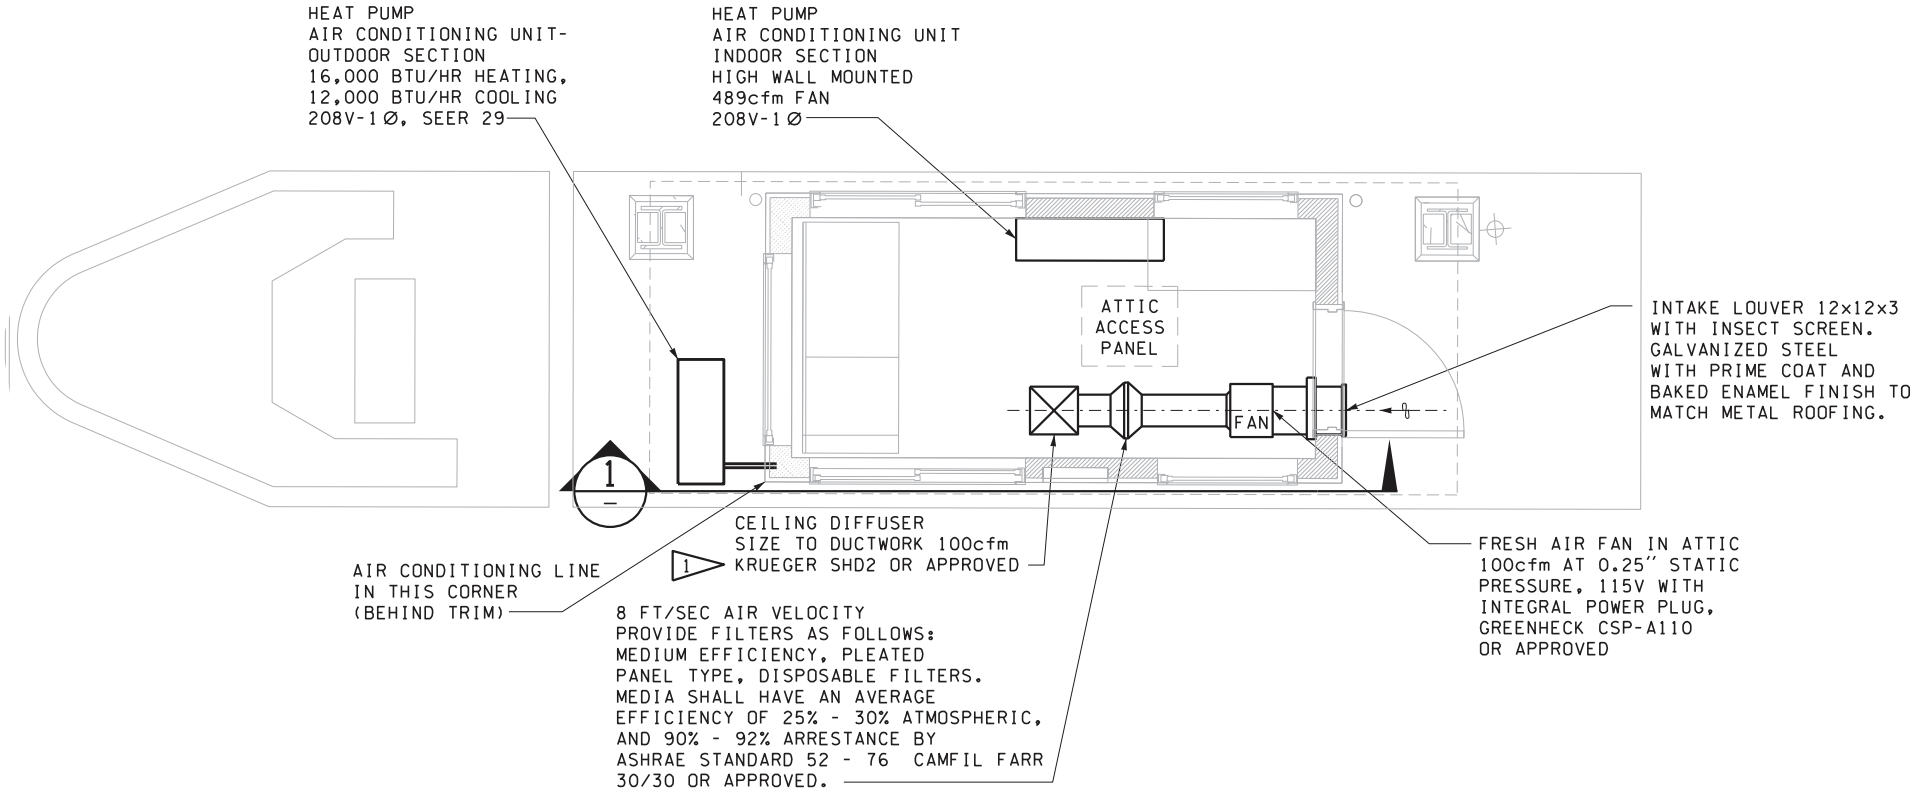

MECHANICAL PLAN AT CEILING

FILE NAME: WSF\Mukilteo\14W121_FerryTermConst\CADD\WSF\ 14w121mx01_20.dlv												SR 525 MUKILTEO FERRY TERMINAL (PHASE 2) FERRY TERMINAL CONSTRUCTION	MX01.20
PRINTED: 12:54:02 PM 9/21/2018	LAST PRINTED BY:						FED.AID PROJ.NO.						
SUBMITTAL DATE: 9/21/2018	Morin						WA-2017-007-00						
DESIGNED BY: N. SANDBERG	9/21/2018						REGION NO. STATE						
ENTERED BY: M. MORIN	9/21/2018						10 WASH						
CHECKED BY: J. SCHUFREIDER	9/21/2018						JOB NUMBER						
MAR PROJ ENGR: C. TORRES	9/21/2018						18W121						
DIR TERM ENGR: N. MCINTOSH							CONTRACT NO.						
ASST SECRETARY: A. SCARTON							00****						
			REVISION	DATE	BY								

MECHANICAL PLANS AND SECTIONS		SHEET 1405 OF 1521 SHEETS
-------------------------------	--	---------------------------------------

