FED. ROAD DIST. No.	STATE	FED. AID PROJ. No.	FISCAL YEAR	SHEET No.	TOTAL SHEETS
1	WASH.	167-C	1929	4	15
10		F-004-2( )			

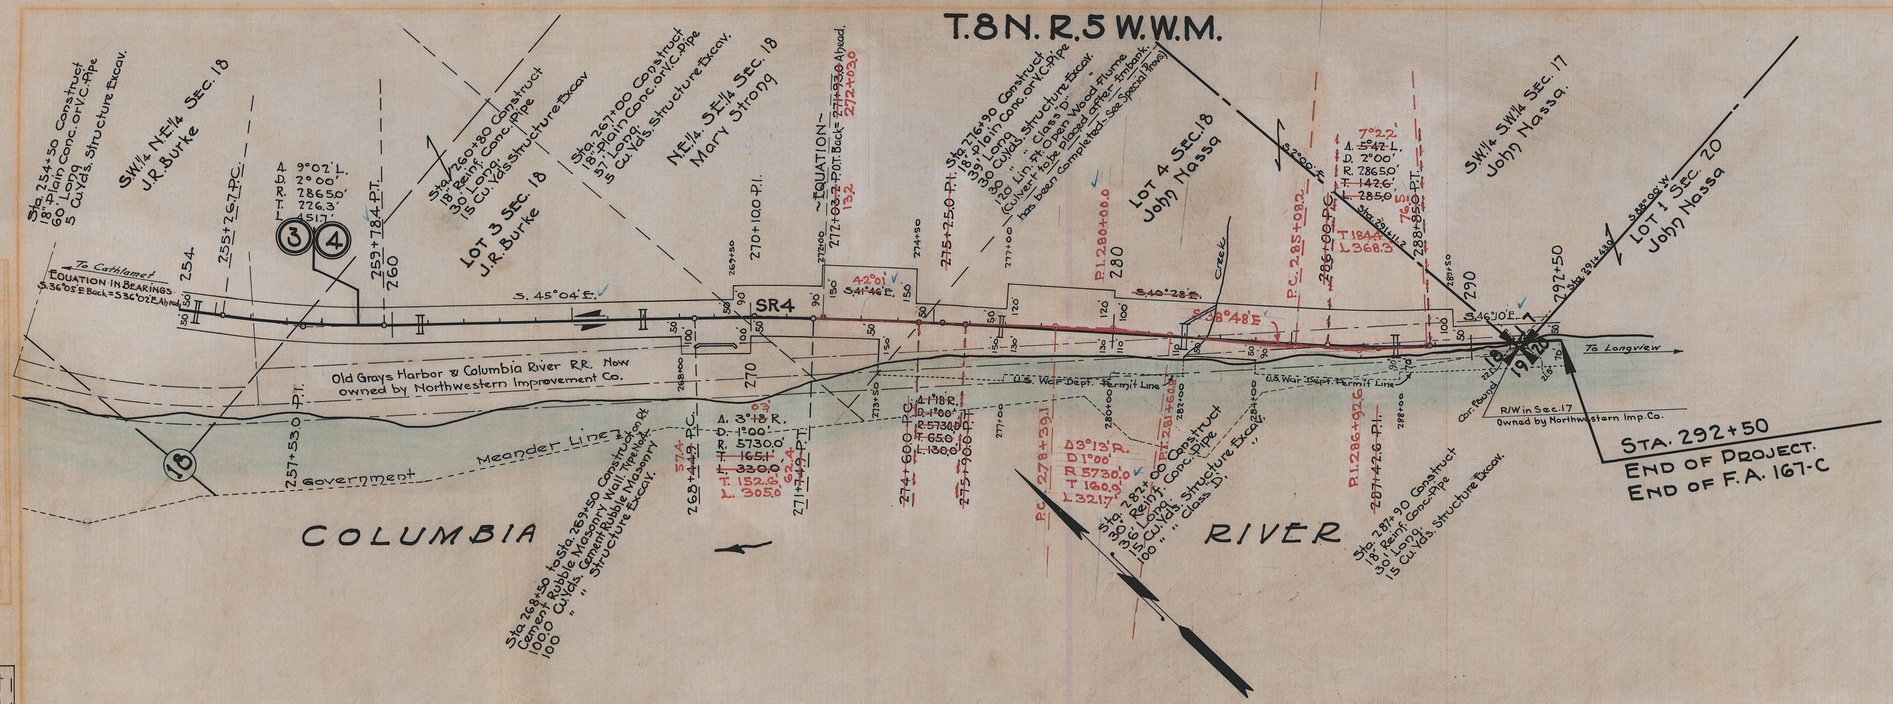

Date	Revision	By
5-20-32	R/W Checked & shown as acquired	J.P.Jr.
6-28-30	Rev. As Constructed.	King.
4-16-28	Tie to Cor. 17-18-19-20 Added	G.E.J.
2-4-28	Ry. Right of Way added	A.T.K.

SR4 (SR 830)
~~STATE ROAD NO. 12~~
CATHLAMET TO EAGLE CLIFF
WAHKIAKUM COUNTY

STATE OF WASHINGTON
STATE HIGHWAY DEPARTMENT
OLYMPIA, WASHINGTON

SCALE: HOR. 1 INCH = 200 FT. VERT. 1 INCH = 20 FT.
APPROVED: JAN. 10, 1928

Samuel Hammond
STATE HIGHWAY ENGINEER

SHEET 3 OF 9 SHEETS
CONTRACT NUMBER 1232.

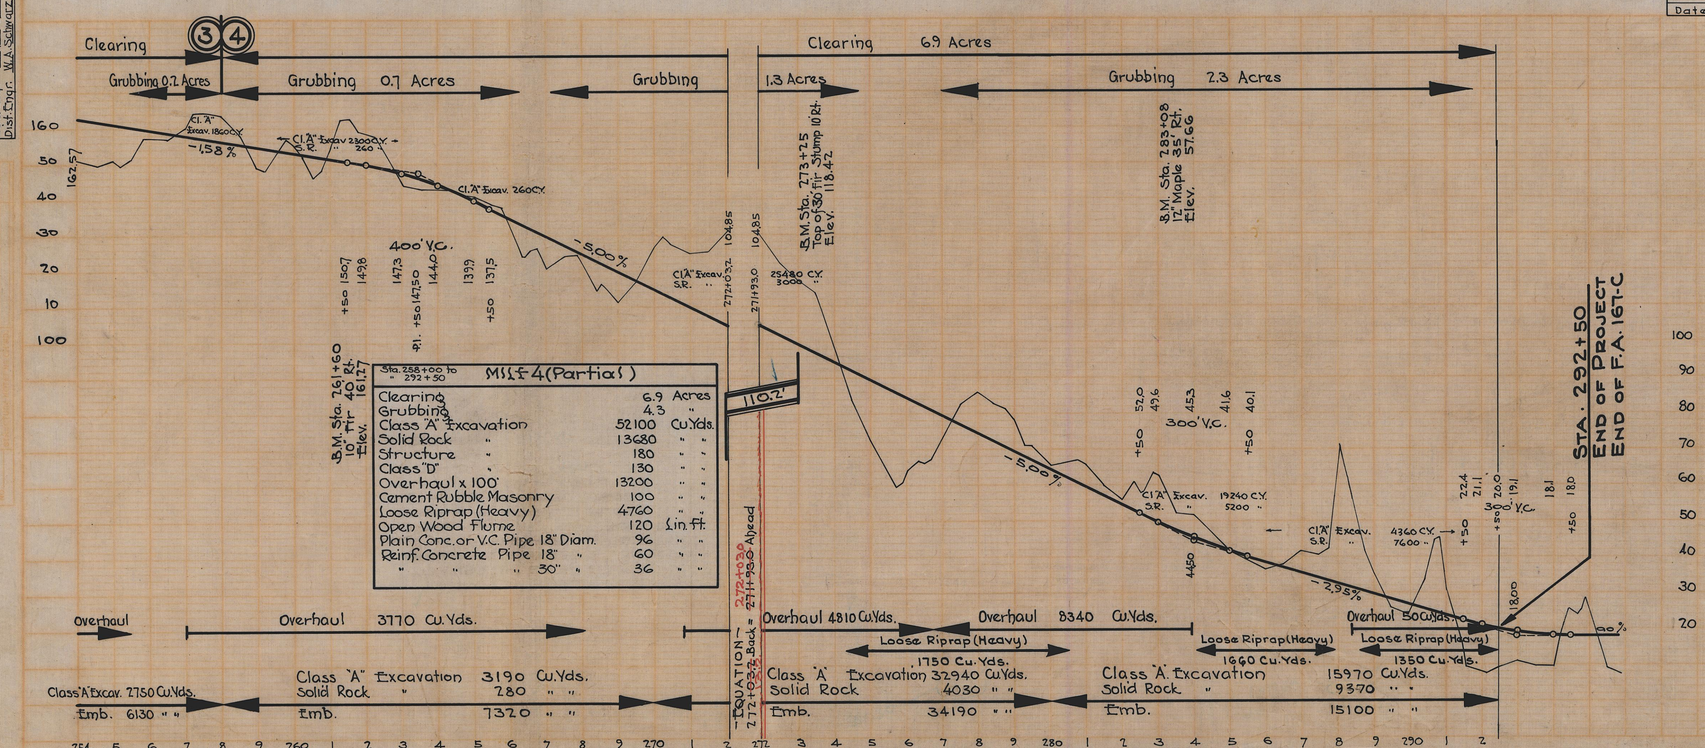

Sta. 258+00 to " 292+50	MILE 4 (Partial)	
Clearing	6.9	Acres
Grubbing	4.3	"
Class "A" Excavation	52100	Cu.Yds.
Solid Rock "	13680	" "
Structure "	180	" "
Class "D" "	130	" "
Overhaul x 100'	13200	" "
Cement Rubble Masonry	100	" "
Loose Riprap (Heavy)	4760	" "
Open Wood Flume	120	Lin. Ft.
Plain Conc. or V.C. Pipe 18" Diam.	96	" "
Reinf. Concrete Pipe 18" "	60	" "
" " " 30" "	36	" "

DRAWER 7-B D-2