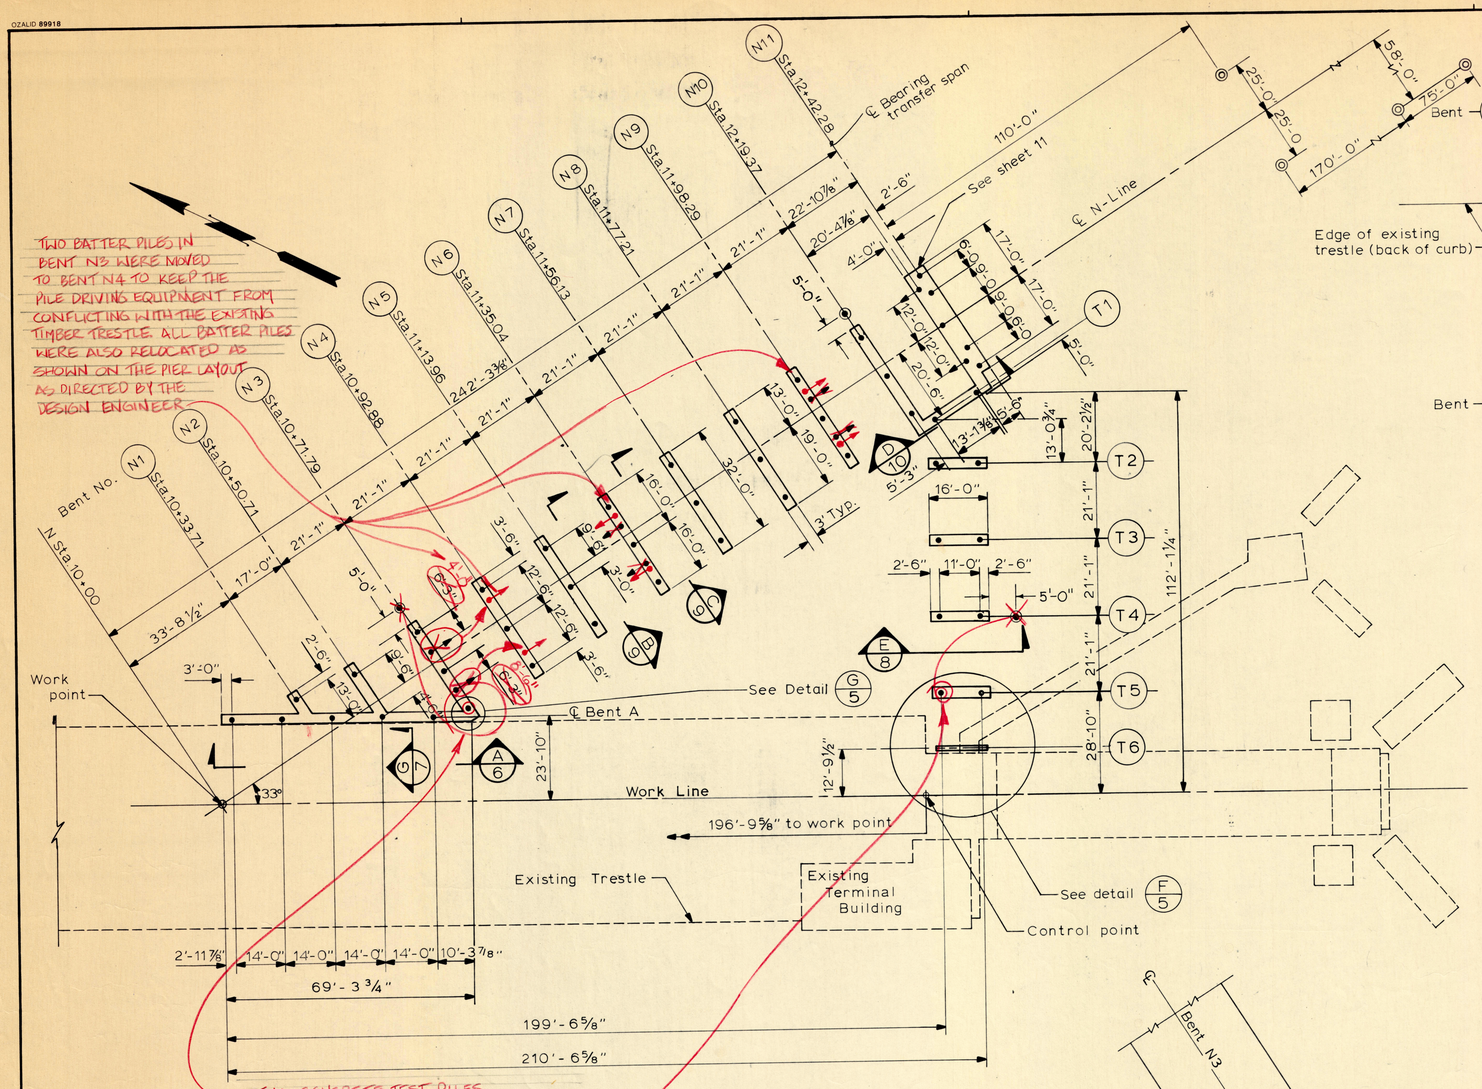

PIER LAYOUT

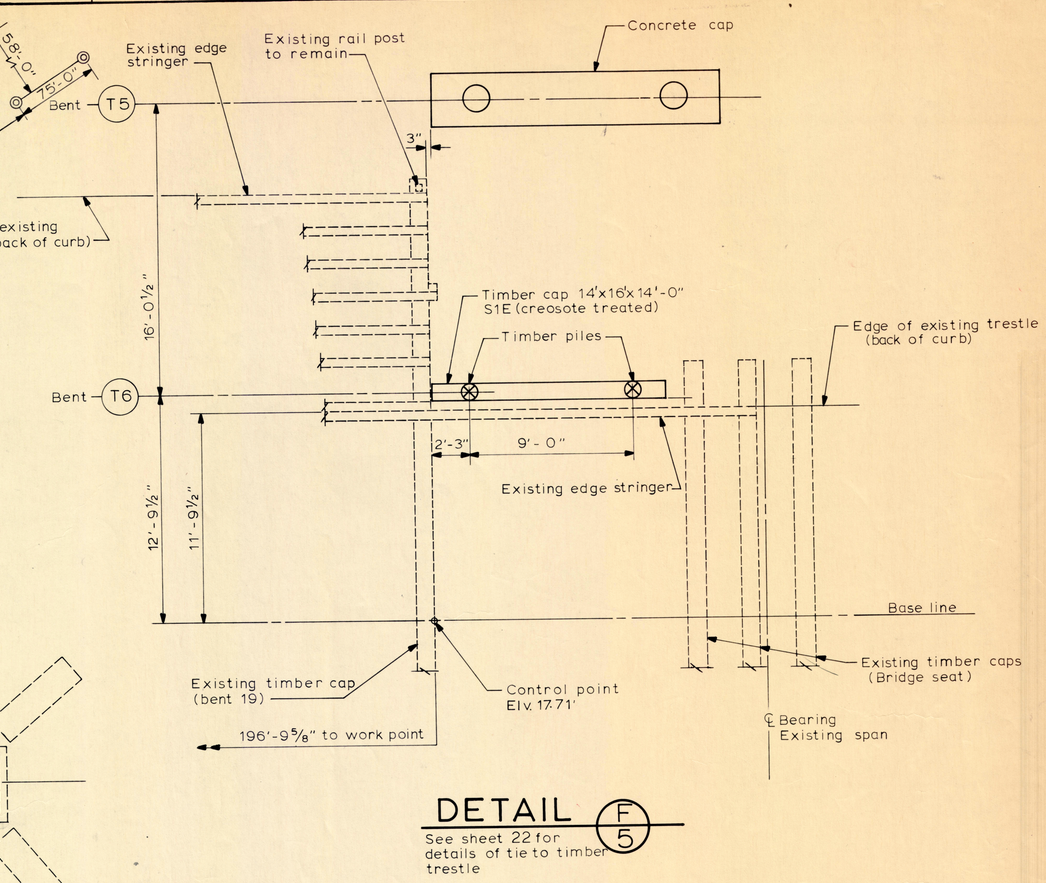

DETAIL F/5

See sheet 22 for details of tie to timber trestle

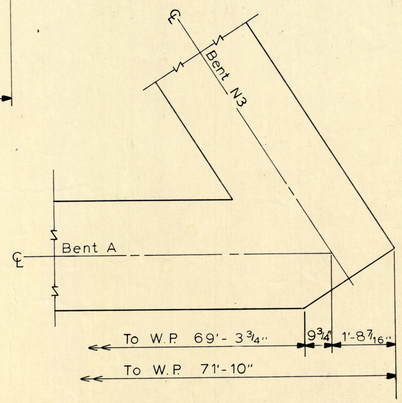

DETAIL G/5

LEGEND

- • Plumb pile
- ⟷ Batter pile
- ◉ Conc. test pile location (Bents N3, N10, T4).
- ◎ Timber test pile location.

Notes:

1. For General Notes, see sheet No 1
2. For location of Control Point, see Note 2 of sheet No 3.

AS BUILT PLANS

CHECKED BY	MW	9/85				
DESIGNED BY	RJP	9/85				
DETAILED BY	TN	9/85	5-6-86	Rev. Timber Cap Dimensions in F/5	KK	JJm
DRAWN BY	G²	8/85	2/25/86	Deleted note 3, moved concrete test piles	RJP	
		DATE	DATE	REVISION	BY	APP'D

REGION NO.	STATE	FED. AID PROJ. NO.	SHEET NO.	TOTAL SHEETS
10	WASH			

JOB NUMBER 86W026

CONTRACT NO. 3159

Washington State Department of Transportation

MARINE TRANSPORTATION
KINGSTON FERRY TERMINAL
AUXILIARY SLIP

PILE AND CAP LAYOUT

SHEET 5 OF 42 SHEETS

C-18/1761

DOT FORM 221-012 Revised 6/80